4638721951

IREDELL COUNTY HEALTH DEPARTMENT

STATESVILLE 704-878-5305 MOORESVILLE 704-664-5281

IMPROVEMENT PERMIT / AUTHORIZATION TO CONSTRUCT / OPERATION PERMIT / EXISTING SYSTEM INSPECTION

PERMIT# 134355 PIN# 4638721951.035 Shawn DATE 7-11-07

OWNER OR APPLICANT Cobble Creek Custom Homes PHONE: Business 369-9856 Home 828 241 4150

ADDRESS 1658 Maggie St Catawba NC 28609

LOCATION Hwy 150 W TR Perth Rd TL Bay Park Place on right Before Normandy Rd

SUBDIVISION Grand Bay BLOCK / SECTION 5 LOT 35 LOT AREA .62 Acre SITE CLASS. PS DESIGN FLOW 480 gpd T.A.R. .3

Septic Tank: 1000 Gallons: STB 1012 Date 5/1/07

Pump Tank: _____ Gallons: PT _____ Date _____

Pump Make: _____ Model _____ Serial No. _____

Nitrification Field: No Fields 1 Square Feet 1200' Linear Feet 400'

No Lines 4@100' Trench Width 36" Max Trench Bottom Depth 36" Gravel Depth N/A

☒ New System ☐ Repair ☐ Expansion System Type: I ⓘ III IV V VI

System Description: Gravity - 25% Reduction

Repair System Description: LP - Panel Block

Maintenance Agreement Required: ☐ Yes ☒ No

☒ Gravity ☐ Pressure

☒ House/Mod. Home No. Bedrooms 4

☐ Mobile Home No. Persons ____

☐ Business No. Employees ____

☐ Other ____


Water Supply: ☒ Individual ☐ Public ☐ Community

☐ Slab ☐ Crawl Space ☐ Basement w/plumbing ☐ Basement wo/plumbing

Comments:/Conditions:

Comments:/Conditions: ☆Note: Can not Cut lot > 2 Ft within 15 Ft from Septic System

Scale 1:50 INITIAL SITE SKETCH

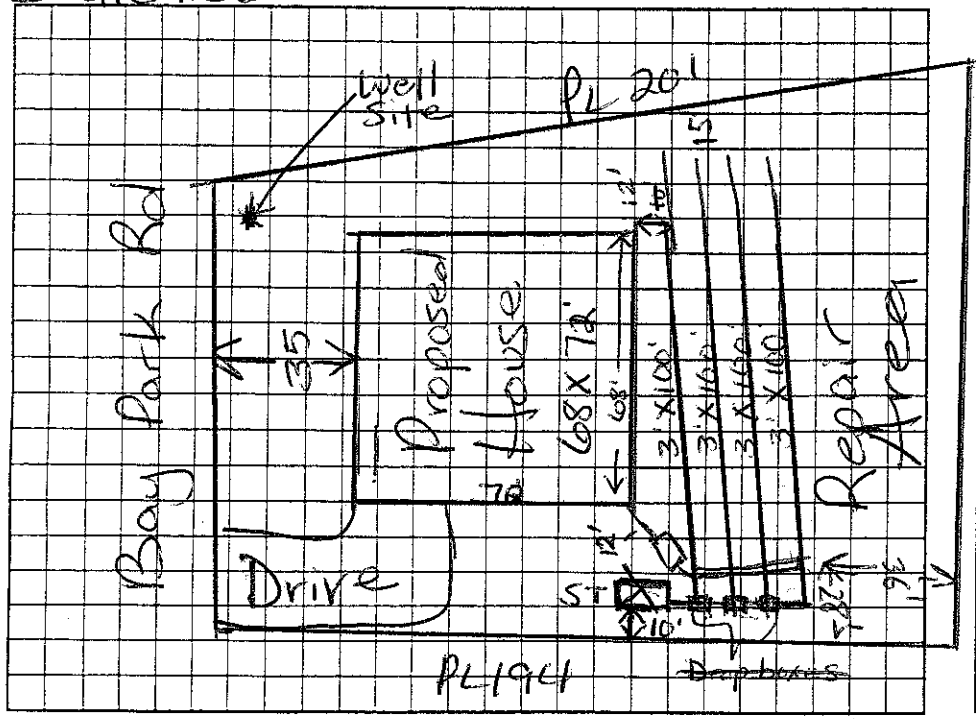

AS BUILT SKETCH

Infi/Harbor Quick 4 Installed using Infi/Harbor drop downs

PL 15'

Permit can be suspended or revoked if any false information is supplied toward securing the permit/any unauthorized changes are made to the site/any unauthorized changes are made in the installation of the system. Improvement Permit with plat valid without expiration ☐ Improvement Permit with site plan valid for sixty months ☐ Authorization to Construct is valid for a period equal to that of Improvement Permit – not to exceed sixty months.

Signed: X _____ date 7/12/07 Installed by: Steve Jordan

Improvement Permit by: _____ date 7/12/07 Operation Permit by: Anthony Cobern date 2/20/08

Authorization to Construct by: _____ date 7/12/07 Existing System Inspection by: _____ date _____

HEALTH DEPT. COPY: WHITE OWNER COPY (FINAL): YELLOW OWNER COPY (INITIAL): PINK