IREDELL COUNTY HEALTH DEPARTMENT

STATESVILLE 704-878-5305 MOORESVILLE 704-664-5281

IMPROVEMENT PERMIT / AUTHORIZATION TO CONSTRUCT / OPERATION PERMIT / EXISTING SYSTEM INSPECTION

PERMIT# 3522 / 068309 PIN# 4638 72 3651 DATE 6/17/99

OWNER OR CONTRACTOR Michael Lassiter PHONE: Business 201-2377 Home

ADDRESS Perth Rd. Mooresville, NC. 28115

LOCATION Perth Rd. N, on (L) just past Catawba Rd.

SUBDIVISION BLOCK / SECTION LOT 2 LOT AREA .74 SITE CLASS PS DESIGN FLOW 360 L.T.A.R. .3

Septic Tank: 1000 Gallons; STB 825 Date 4/8/99

Pump Tank: Gallons; PT Date

Pump Make: Model Serial No.

Nitrification Field: No Fields 1 Square Feet 900 Linear Feet 300

No Lines 3 Trench Width 36" Max Trench Bottom Depth 36-42" Gravel Depth SAND.

[X] New System [ ] Repair System Type: I, II, (III), IV, V, VI

System Description: GRAV-CH PLASTIC OR NDS

Repair System Description: SAME

Maintenance Agreement Required: [ ] Yes [ ] No

[X] House/Mod. Home No. Bedrooms 3

[ ] Mobile Home No. Bathrooms 2

[ ] Business No. Employees


[ ] Other

[ ] Slab [X] Crawl Space [ ] Basement w/plumbing [ ] Basement wo/plumbing

Water Supply: [X] Individual [ ] Public [ ] Community

Comments/Conditions:

INITIAL SITE SKETCH

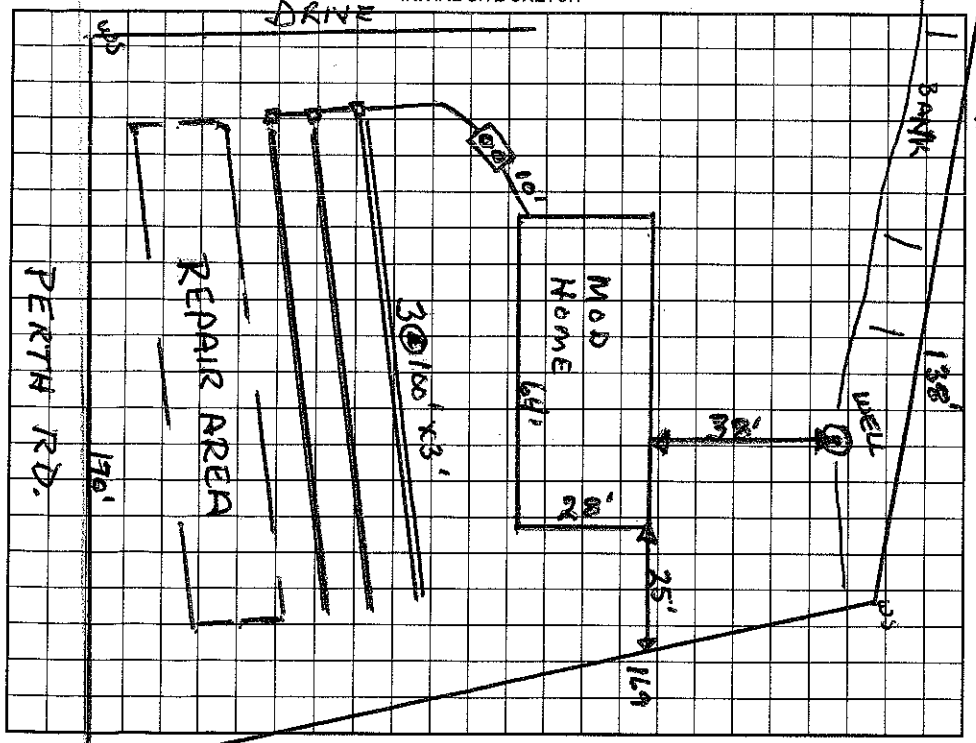

Comments/Conditions:

AS BUILT SKETCH

Permit can be suspended or revoked if any false information is supplied toward securing the permit/any unauthorized changes are made to the site/any unauthorized changes are made in the installation of the system. Improvement Permit with plat valid without expiration. Improvement Permit with site plan valid for sixty months. Authorization to Construct is valid for a period equal to that of Improvement Permit – not to exceed sixty months.

Signed: * Michael Lassiter date 6/20/99

Improvement Permit by: Wesley Sparks R.S. date 6/17/99

Authorization to Construct by: Wesley Sparks R.S. date 6/17/99

Installed by: Piedmont Septic Tank

Operation Permit by: Wesley Sparks R.S. date 6/24/99

Existing System Inspection by: date

HEALTH DEPT. COPY: WHITE OWNER COPY (FINAL): YELLOW OWNER COPY (INITIAL): PINK