# IREDELL COUNTY HEALTH DEPARTMENT

STATESVILLE 704-878-5305 MOORESVILLE 704-664-5281

## IMPROVEMENT PERMIT / AUTHORIZATION TO CONSTRUCT / OPERATION PERMIT / EXISTING SYSTEM INSPECTION

PERMIT# 142416 PIN# 4638724231 DATE 7/11/07

OWNER OR APPLICANT Denise Moose PHONE: Business 704 450-2711 Home

ADDRESS 2231 Perth Rd. Mooresville NC 28117

LOCATION Hwy 150W TR on Perth Rd on right (2231 Perth Rd.)

SUBDIVISION BLOCK / SECTION LOT LOT AREA SITE CLASS. DESIGN FLOW 360 L.T.A.R.

Existing

Septic Tank: 1000 Gallons; STB Existing Date

Pump Tank: Gallons; PT Existing Date

Pump Make: Model Serial No.

Nitrification Field: No Fields Square Feet Linear Feet

No Lines Trench Width Max Trench Bottom Depth Gravel Depth ☑ Gravity ☐ Pressure

☐ New System ☐ Repair ☐ Expansion System Type: I (II) III IV V VI

System Description: Existing System

Repair System Description:

Maintenance Agreement Required: ☐ Yes ☐ No

☐ House/Mod. Home No. Bedrooms 3

☐ Mobile Home No. Persons

☐ Business No. Employees

☐ Other

Water Supply: ☑ Individual ☐ Public ☐ Community

☑ Slab ☐ Crawl Space ☐ Basement w/plumbing ☐ Basement wo/plumbing

Comments/Conditions:


Comments/Conditions:

keep 5' min separation from tank to home or Deck foundation

INITIAL SITE SKETCH

NTS

AS BUILT SKETCH

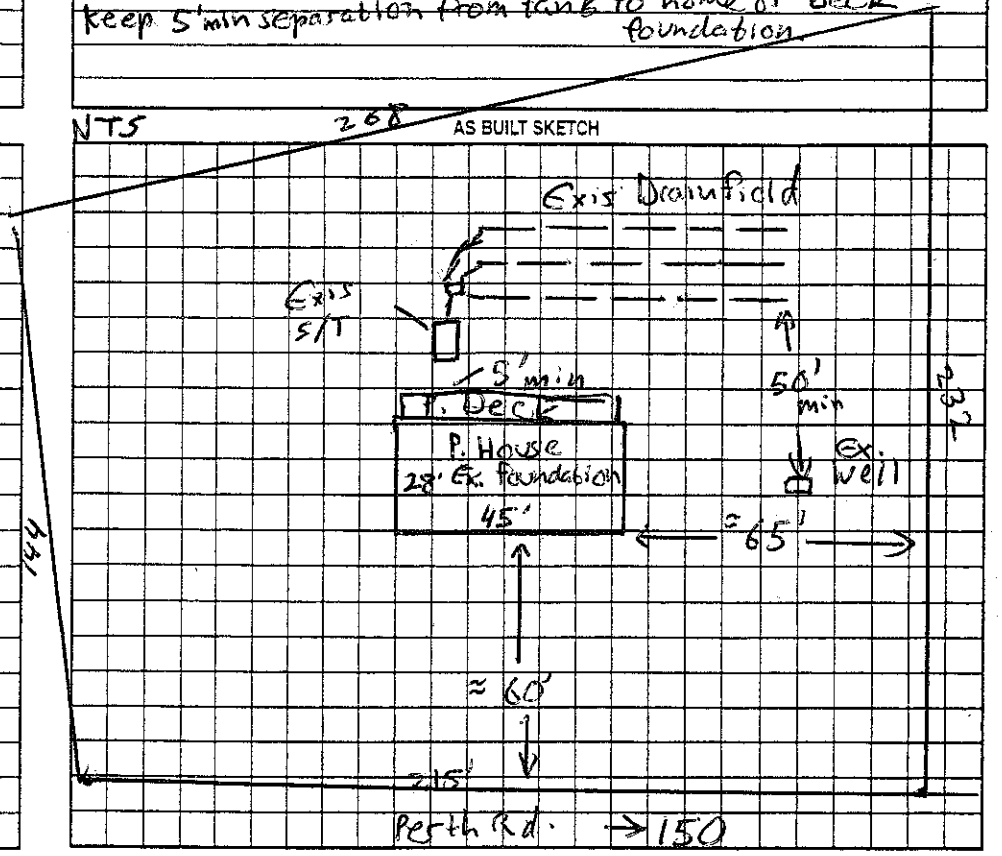


Permit can be suspended or revoked if any false information is supplied toward securing the permit/any unauthorized changes are made to the site/any unauthorized changes are made in the installation of the system. Improvement Permit with plat valid without expiration ☐ Improvement Permit with site plan valid for sixty months ☐ Authorization to Construct is valid for a period equal to that of Improvement Permit – not to exceed sixty months.

Signed: date 7/11/07 Installed by:

Improvement Permit by: date Operation Permit by: date

Authorization to Construct by: date Existing System Inspection by: Anthony Coleman date 7/11/07

HEALTH DEPT. COPY: WHITE OWNER COPY (FINAL): YELLOW OWNER COPY (INITIAL): PINK