3:30 - 4:00

IREDELL COUNTY HEALTH DEPARTMENT

STATESVILLE 704-878-5305 MOORESVILLE 704-664-5281

IMPROVEMENT PERMIT / AUTHORIZATION TO CONSTRUCT / OPERATION PERMIT / EXISTING SYSTEM INSPECTION

PERMIT# 74779 PIN# 4638637244 PT 4638730163 DATE 7/26/99

OWNER OR CONTRACTOR LAKESHORE DEVELOPMENT (RAY SHORT) PHONE: Business Home

ADDRESS 386 WILLIAMSON RD. MOORESVILLE NC 28115

LOCATION DEPOT - TL NORMANDY - ON LEFT AFTER GRANDBAY

SUBDIVISION GRANDBAY BLOCK / SECTION II LOT 31 LOT AREA .53AC SITE CLASS PS DESIGN FLOW 360 L.T.A.R. .4 gal/dd

Septic Tank: 1000 Gallons; STB 825 Date 1-5-2000

Pump Tank: 1000 Gallons; PT ~~825~~ 47 Date 1-6-2000

Pump Make: Zoeller Model N148B Serial No. 140 000 2

Nitrification Field: No Fields 1 Square Feet 720 Linear Feet 240

No Lines 4@60' Trench Width 36" Max Trench Bottom Depth 36" Gravel Depth N/A

☑ New System ☐ Repair System Type: I, II, III, IV, V, VI

System Description: PUMP 25% REDUCTION

Repair System Description: PUMP TANK C

Maintenance Agreement Required: ☐ Yes ☑ No

☑ House/Mod. Home No. Bedrooms 3

☐ Mobile Home No. Bathrooms 2

☐ Business No. Employees

☐ Other

☐ Slab ☑ Crawl Space ☐ Basement w/plumbing ☐ Basement wo/plumbing


Water Supply: ☑ Individual ☐ Public ☐ Community

Comments:/Conditions:


Comments:/Conditions:

111=40'

INITIAL SITE SKETCH

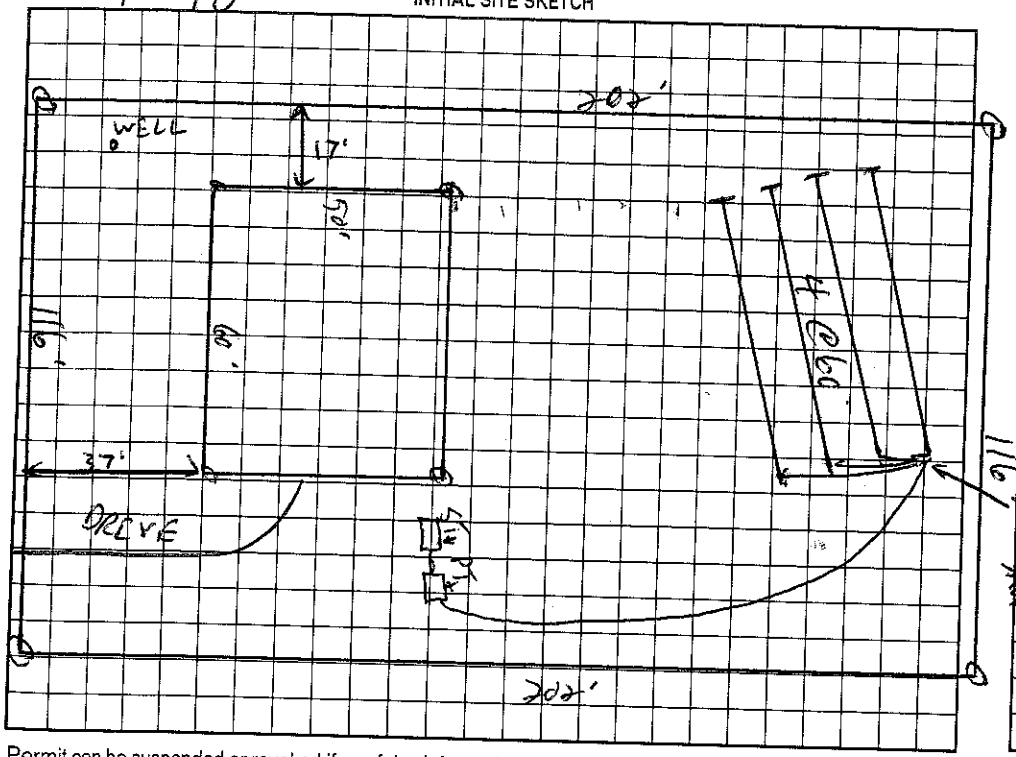

AS BUILT SKETCH

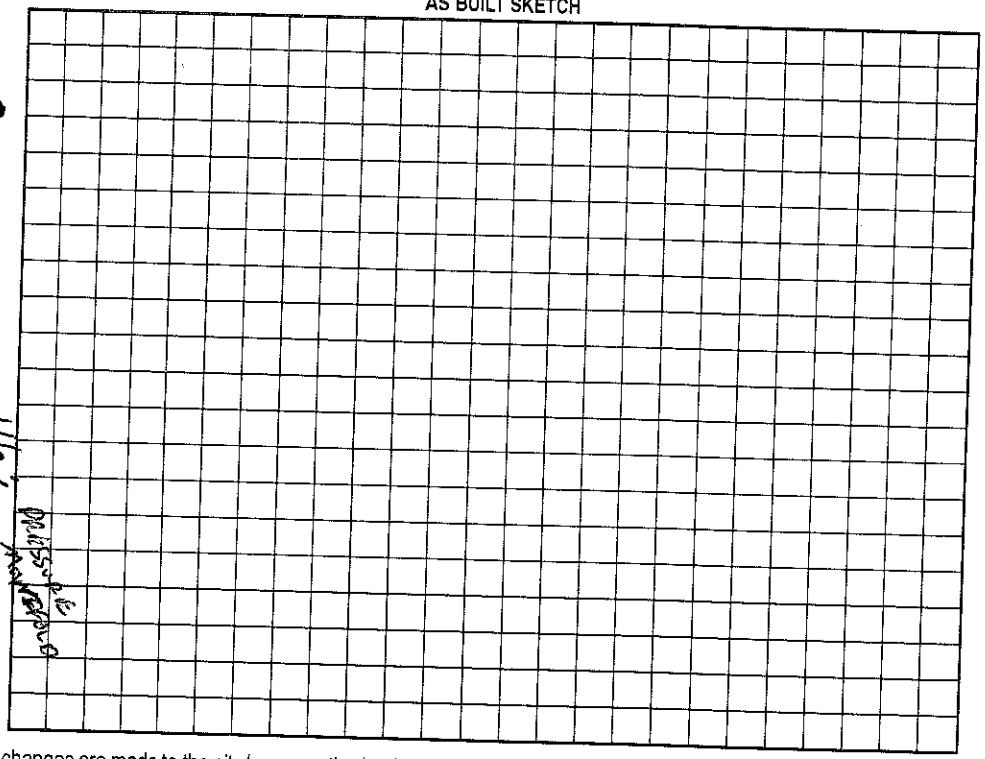

Permit can be suspended or revoked if any false information is supplied toward securing the permit/any unauthorized changes are made to the site/any unauthorized changes are made in the installation of the system. Improvement Permit with plat valid without expiration. Improvement Permit with site plan valid for sixty months. Authorization to Construct is valid for a period equal to that of Improvement Permit – not to exceed sixty months.

Signed: [signature] date 8-6-99 Installed by: Wayne Clontz

Improvement Permit by: [signature] RS date 7/26/99 Operation Permit by: Wesley Banks RS date 5/3/00

Authorization to Construct by: [signature] RS date 7/26/99 Existing System Inspection by: date

HEALTH DEPT. COPY: WHITE OWNER COPY (FINAL): YELLOW OWNER COPY (INITIAL): PINK