...DELL COUNTY HEALTH DEPARTMENT ... 704-878-5305 MOORESVILLE 704-66...

IMPROVEMENT PERMIT / CERTIFICATE OF COMPL... / OPERATION PERMIT / EXISTING SYSTEM ...

PROPERTY DESCRIPTION NO. 19489 DATE 3/1/96 TAX MAP NO. 2PA 14 Pt of 4638 73 1397 Watersh... ☒ Yes ☐ No

OWNER OR CONTRACTOR K2 Custom Builders PHONE: Business 892-9104 Home

ADDRESS 2046A Chantwell Lyn. Dr. Davidson, NC 28036

LOCATION Normandy Rd. - Perth N TL Normandy Rd. 2 NW on (R) below Grand Bay Drive

SUBDIVISION Grand Bay BLOCK / SECTION 2 LOT 5 LOT AREA 1.1/2 AC SITE CLASS. A DESIGN FLOW 480 L.T.A.R. .3

Septic Tank: 1000 Gallons; STB 794 Date 4/25/96

Pump Tank: 1000 Gallons; PT 27 Date 4/3/96

Pump Make: ____ Model ____ Serial No. ____

Nitrification Field: No Fields 1 Square Feet 1600 Linear Feet *400

No Lines 3 or 4 Trench Width 36" Max Trench Bottom Depth 36" Gravel Depth 6"

☒ New System ☐ Repair System Type: I, II, (III), IV, V, VI

System Description: Chem-Tech Septic - Pres Manifold

Repair System Description: Same

Maintenance Agreement Required: ☐ Yes ☒ No

☒ House/Mod. Home ☐ Mobile Home ☐ Business ☐ Other

No. Bedrooms 4 No. Bathrooms 3 No. Employees ____

☐ Slab ☒ Crawl Space ☐ Basement w/plumbing ☐ Basement wo/plumbing


Water Supply: ☒ Individual ☐ Community ☐ Public

Comments: Basement area AS
* Chambered Septic off Pres Manifold
* Sand backfill to top of sleeves
* Color Code supply lines to Manifold


Comments: (RED - 5) (7 - BLUE)

[1" = 100']

INITIAL SITE SKETCH

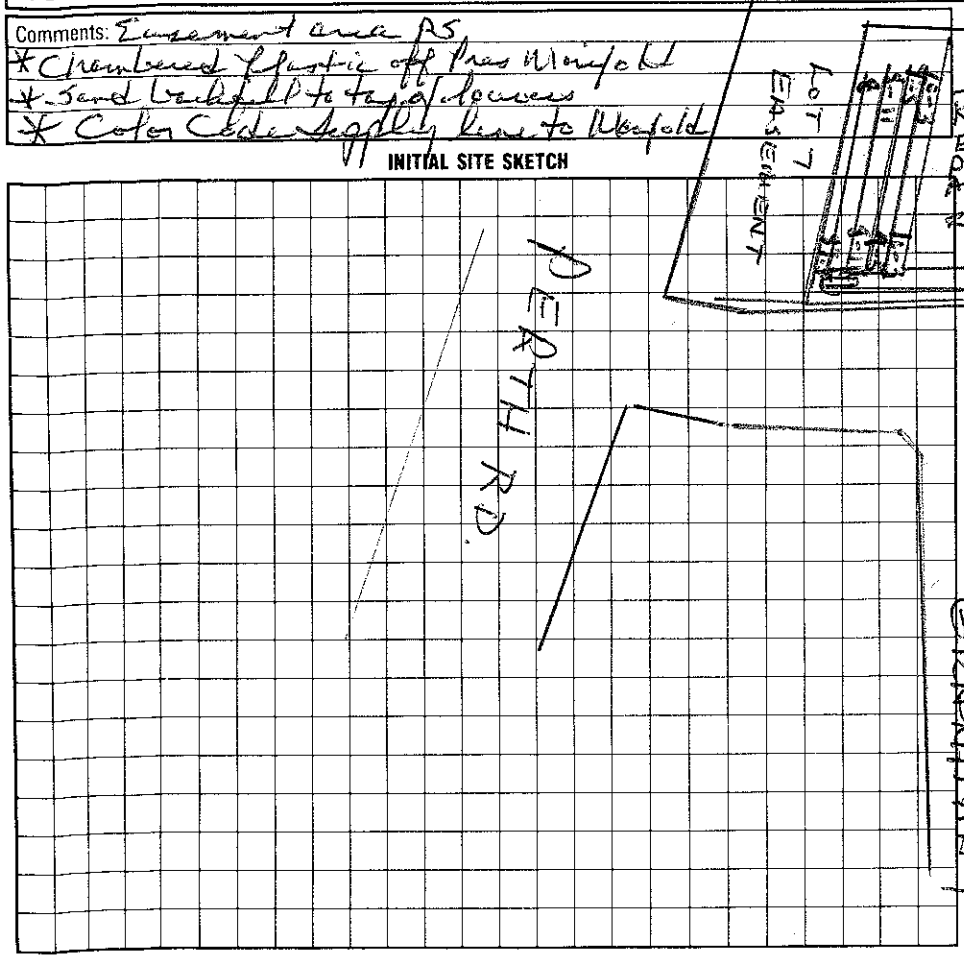

AS BUILT SKETCH

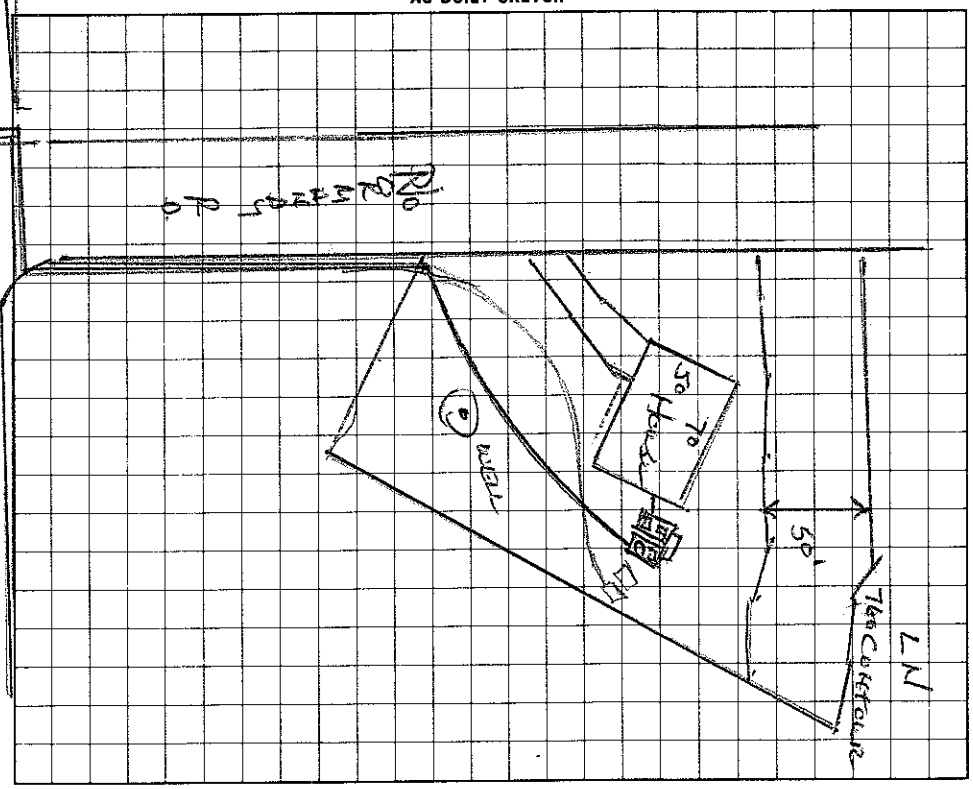

I understand that this permit can be suspended or revoked if any false information is supplied toward securing the permit/any unauthorized changes are made to the site/any unauthorized changes are made in the installation of the system.

Authorization to Construct Valid 5 years

Signed: Edward Murray

Improvement Permit by: Wesley Sparks RS. date 3/1/96

Existing System Inspection by: Construct Wesley Sparks RS date 3/1/96

Installed by: Bob Mayhew

Certificate of Completion by: ____ date ____

Operation Permit by: Wesley Sparks RS. date 9/27/96

HEALTH DEPT. COPY: WHITE INSPECTION COPY (FINAL): GREEN OWNER COPY (FINAL): YELLOW INSPECTION COPY (INITIAL): PINK OWNER COPY (INITIAL): GOLD