IREDELL COUNTY HEALTH DEPARTMENT

STATESVILLE 704-878-5305 MOORESVILLE 704-664-5281

IMPROVEMENT PERMIT / AUTHORIZATION TO CONSTRUCT / OPERATION PERMIT / EXISTING SYSTEM INSPECTION

PERMIT# 074783 PIN# 4634637244 4638-73-3101 DATE 11/5/98

OWNER OR CONTRACTOR RAY SHORT PHONE: Business Home

ADDRESS STUTTS RD - MOORESVILLE 28117

LOCATION PERTH RD - TL NORMANDY RD - 300FT ON LT

SUBDIVISION GRAND BAY BLOCK / SECTION LOT 33 LOT AREA .53AC SITE CLASS. AS DESIGN FLOW 360 L.T.A.R. .49 ac/AA2

Septic Tank: 1000 Gallons; STB 794 Date 12/29/98

Pump Tank: 1000 Gallons; PT 27 Date 2/11/99

Pump Make: Gould Model WE0511H Serial No. M9834710

Nitrification Field: No Fields 1 Square Feet 675 Linear Feet 225

No Lines 3 @ 75' Trench Width 36" Max Trench Bottom Depth 36" Gravel Depth N/A

☑ New System ☐ Repair System Type: I, II, (III), IV, V, VI

System Description: PUMP CHAMBERS OR HDS

Repair System Description: PUMP PANEL

Maintenance Agreement Required: ☐ Yes ☑ No

☑ House/Mod. Home ☐ Mobile Home ☐ Business ☐ Other

No. Bedrooms 3 No. Bathrooms 2 No. Employees


☐ Slab ☑ Crawl Space ☐ Basement w/plumbing ☐ Basement wo/plumbing

Water Supply: ☑ Individual ☐ Public ☐ Community

Comments:/Conditions:

Comments:/Conditions:

INITIAL SITE SKETCH

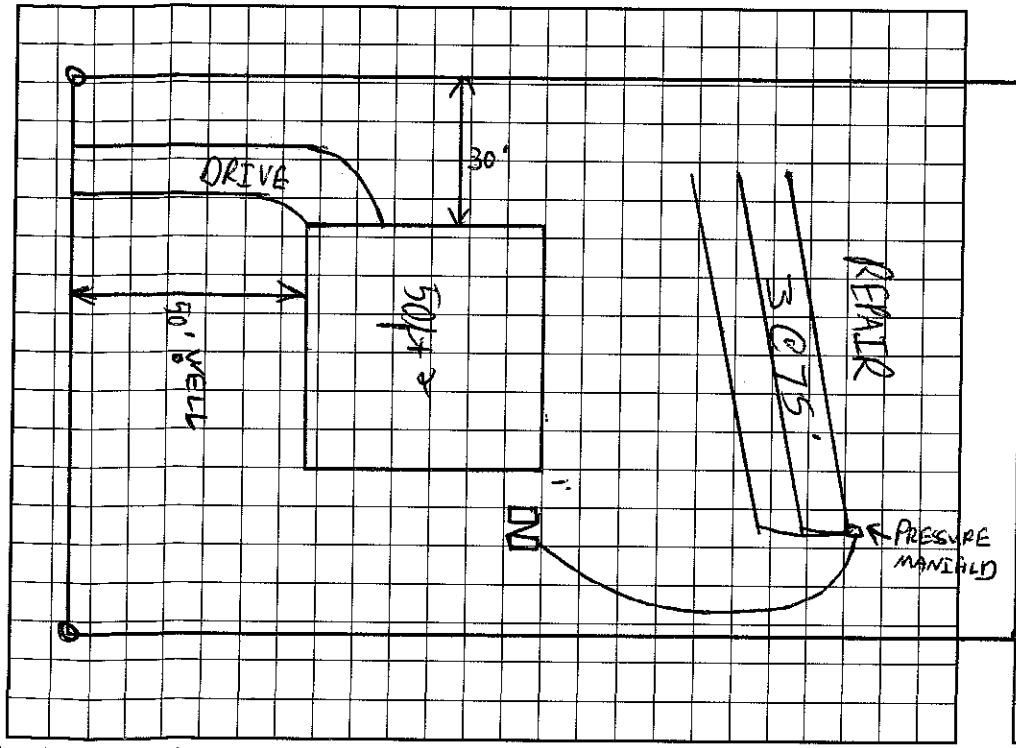

AS BUILT SKETCH

I understand that this permit can be suspended or revoked if any false information is supplied toward securing the permit/any unauthorized changes are made to the site/any unauthorized changes are made in the installation of the system. Improvement Permit with plat valid without expiration. Improvement Permit with site plan valid for sixty months. Authorization to Construct is valid for a period equal to that of Improvement Permit – not to exceed sixty months.

Signed: Ray Short date 11/5/98

Improvement Permit by: C. Ray Zeno RS date 11/5/98

Authorization to Construct by: C. Ray Zeno RS date 11/5/98

5/2/00 House occupied, System operating

Installed by: F.J. Ewin

Operation Permit by: Wesley Sparks RS. date 2/14/01

Existing System Inspection by: date

HEALTH DEPT. COPY: WHITE INSPECTION COPY (FINAL): GREEN OWNER COPY (FINAL): YELLOW INSPECTION COPY (INITIAL): PINK OWNER COPY (INITIAL): GOLD