IREDELL COUNTY HEALTH DEPARTMENT

STATESVILLE 704-878-5305 MOORESVILLE 704-664-5281

IMPROVEMENT PERMIT / ~~CERTIFICATE OF COMPLETION~~ / OPERATION PERMIT / EXISTING SYSTEM INSPECTION

PROPERTY DESCRIPTION NO. 14482 DATE 12/9/97 TAX MAP NO. 2P-15-A-8 4638 733672 Watershed: ☑ Yes ☐ No

OWNER OR CONTRACTOR GRAND BAY ESTATES PHONE: Business ~~[illegible]~~ 663-5115 Home

ADDRESS 386 WILLIAMSON SUITE 104 MOORESVILLE

LOCATION PERTHRO - TL NORMANDY RD - TR GRANDBAY - ON LT.

SUBDIVISION GRAND BAY BLOCK / SECTION 2 LOT 8 LOT AREA 1.21AC SITE CLASS. RS DESIGN FLOW 480 GPD L.T.A.R. .4 GPD/FT

Septic Tank: 1000 Gallons; STB 794 Date 9-4-98

Pump Tank: 1000 Gallons; PT 27 Date 10-16-98

Pump Make: Goulds Model WE0511H Serial No. J9841034

Nitrification Field: No Fields 1 Square Feet 900 Linear Feet 300

No Lines 4 @ 75' Trench Width 36" Max Trench Bottom Depth 36" Gravel Depth N/A

☑ New System ☐ Repair System Type: I, II, (III), IV, V, VI

System Description: PUMP CHAMBERED ORENDS

Repair System Description: SAME

Maintenance Agreement Required: ☐ Yes ☑ No

☑ House/Mod. Home No. Bedrooms 4

☐ Mobile Home No. Bathrooms 4

☐ Business No. Employees

☐ Other


☐ Slab ☐ Crawl Space ☑ Basement w/plumbing ☐ Basement wo/plumbing

Water Supply: ☑ Individual ☐ Community ☐ Public

Comments: Tanks & Lines Cheaked 11/18/98
Pressure Cheaked 11/18/98

Comments:

INITIAL SITE SKETCH 1"=100'

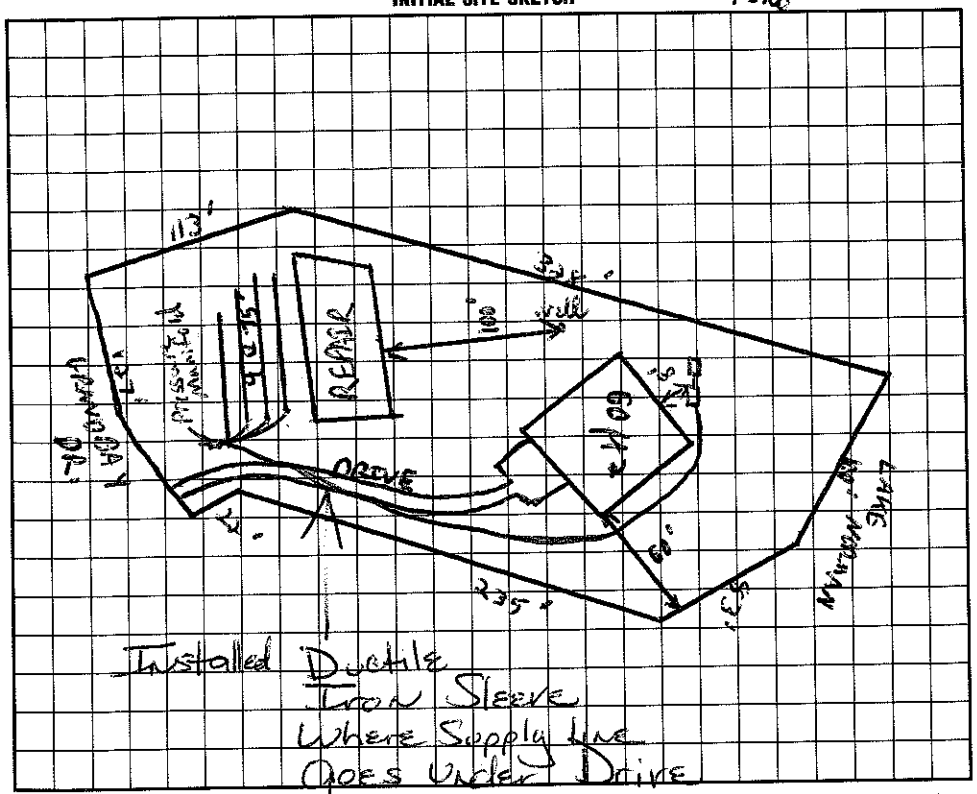

AS BUILT SKETCH

I understand that this permit can be suspended or revoked if any false information is supplied toward securing the permit/any unauthorized changes are made to the site/any unauthorized changes are made in the installation of the system. Improvement Permit is valid for 60 months from date of issuance.

Signed: Randy Murray

Improvement Permit by: RS date 12/9/97

~~Existing System Inspection by:~~ AUTHORIZATION TO CONSTRUCT RS date 3/5/98

Installed by: F.J. Ervin

Certificate of Completion by: date

Operation Permit by: RS date 2/16/99

HEALTH DEPT. COPY: WHITE INSPECTION COPY (FINAL): GREEN OWNER COPY (FINAL): YELLOW INSPECTION COPY (INITIAL): PINK OWNER COPY (INITIAL): GOLD