IREDELL COUNTY HEALTH DEPARTMENT

STATESVILLE 704-878-5305 400 fax MOORESVILLE 704-664-5281

IMPROVEMENT PERMIT / AUTHORIZATION TO CONSTRUCT / OPERATION PERMIT / EXISTING SYSTEM INSPECTION

PERMIT# 090442 PIN# 4638 73 5820 4638 73 3820 DATE 2/8/02

OWNER OR CONTRACTOR Jeff Falandysz PHONE: Business Home 704-660-3432

ADDRESS 280 Griffins Rd. Mooresville, NC. 28115

LOCATION 150w ® Perth (L) Normandy ® Grand Bay to 4th lot on (L)

SUBDIVISION Grand Bay BLOCK / SECTION 2 LOT 9 LOT AREA ~ 1.23Ac SITE CLASS PS DESIGN FLOW 480 L.T.A.R. .3 EASEMENT AREA

Septic Tank: 1000 Gallons; STB 1012 Date 3/23/02
Pump Tank: 1000 Gallons; PT 17 Date 12/7/01
Pump Make: MYERS Model SNF102-205 Serial No.
Nitrification Field: No Fields 1 Square Feet 1200 Linear Feet 400
No Lines 5@80' Trench Width 3' Max Trench Bottom Depth < 36" Gravel Depth No

X New System ☐ Repair System Type: I, II, (III), IV, V, VI
System Description: EZ FLOW - CHAMBERS - Pressure Manifold
Repair System Description: 16" APBPS
Maintenance Agreement Required: ☐ Yes X No

X House/Mod. Home No. Bedrooms 4
☐ Mobile Home No. Bathrooms 4
☐ Business No. Employees
☐ Other


☐ Slab ☐ Crawl Space X Basement w/plumbing ☐ Basement wo/plumbing

Water Supply: X Individual ☐ Public ☐ Community


Comments/Conditions: * HDS or Ch. Plastic w/ 4" SCH 80 PVC Pressure Manifold in protection box
* See attached site plans for Easement Location

Comments/Conditions: * Drainfield + Repair Area are ~ 1500 feet from this lot.
EZ LAY INSTALLED.

INITIAL SITE SKETCH

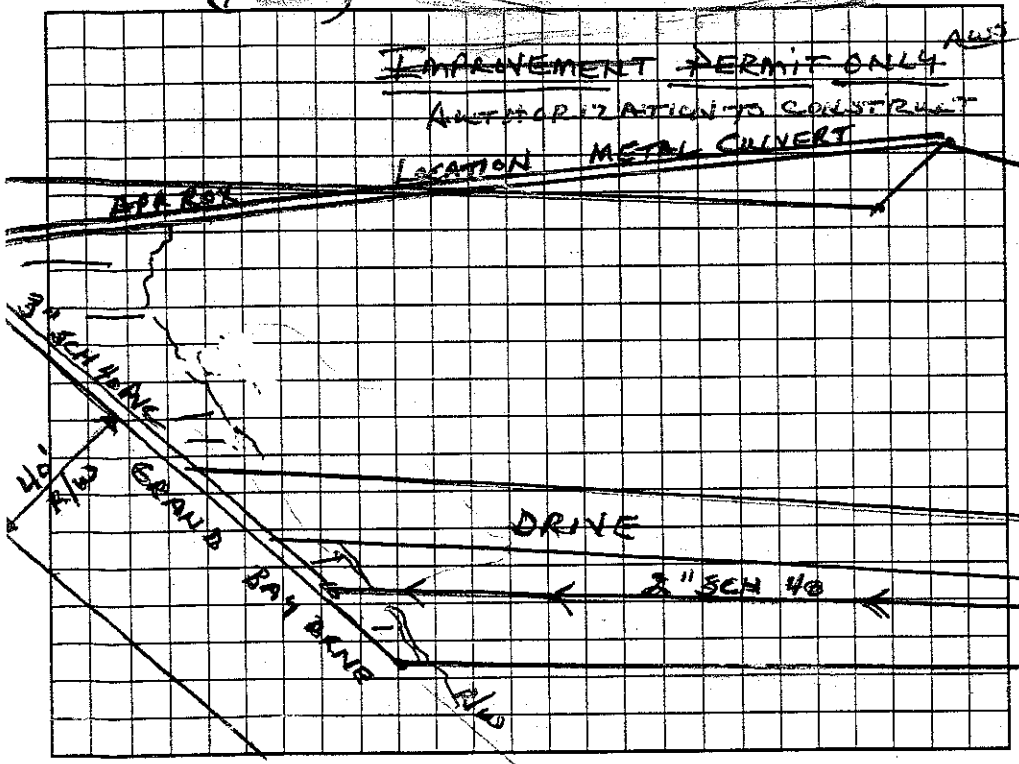

AS BUILT SKETCH

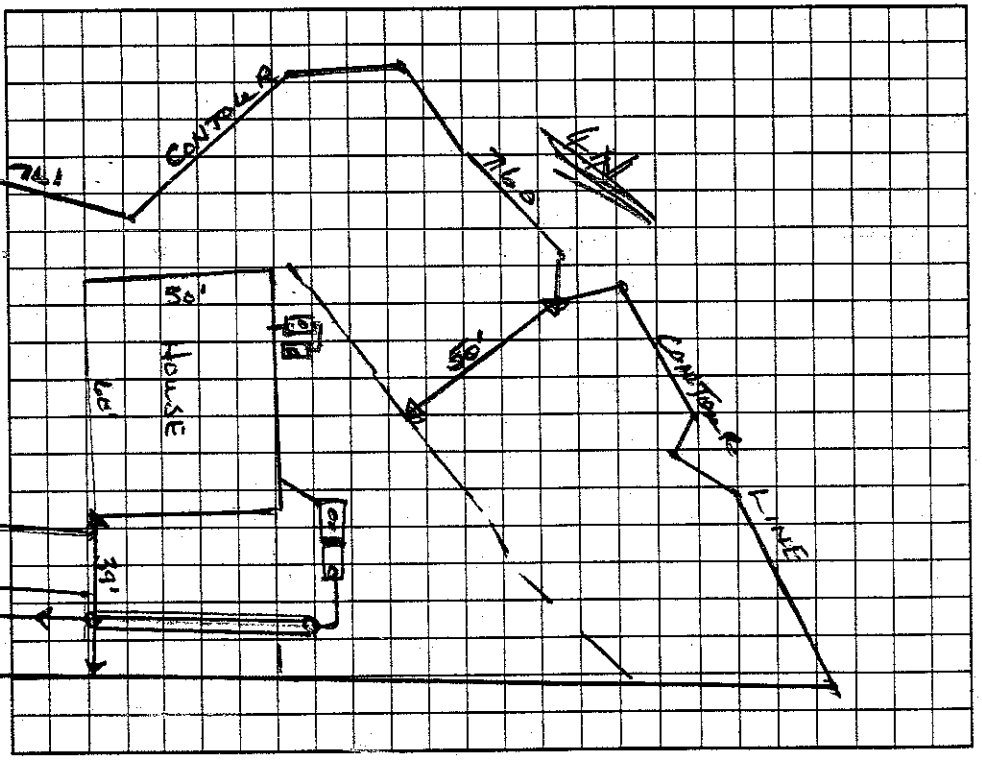

Permit can be suspended or revoked if any false information is supplied toward securing the permit/any unauthorized changes are made to the site/any unauthorized changes are made in the installation of the system. Improvement Permit with plat valid without expiration. Improvement Permit with site plan valid for sixty months. Authorization to Construct is valid for a period equal to that of Improvement Permit – not to exceed sixty months.

Signed: * Danny Edwards date 02-02-02 Installed by: Richard Abernethy

Improvement Permit by: Wesley Sparks R.S. date 9/13/00 Operation Permit by: Wesley Sparks R.S. date 6/14/02

Authorization to Construct by: Wesley Sparks R.S. date 2/8/02 Existing System Inspection by: date

HEALTH DEPT. COPY: WHITE OWNER COPY (FINAL): YELLOW OWNER COPY (INITIAL): PINK