IREDELL COUNTY HEALTH DEPARTMENT

STATESVILLE 704-878-5305 $150.00 Paid MOORESVILLE 704-664-5281

IMPROVEMENT PERMIT / AUTHORIZATION TO CONSTRUCT / OPERATION PERMIT / EXISTING SYSTEM INSPECTION

PERMIT# 089387 PIN# 4638 73 4334 DATE 8/9/04

OWNER OR CONTRACTOR Anaheim Homes Inc PHONE: Business 704-907-9250 Home

ADDRESS PO Box 616 Cornelius, NC. 28031

LOCATION 150 N TR Perth Rd. TC Normandy Rd. TR Grand Bay cornerlot on (L)

SUBDIVISION Grand Bay BLOCK / SECTION 2 LOT 6 LOT AREA .77AC SITE CLASS. PS DESIGN FLOW 480 L.T.A.R. .3

Septic Tank: 1000 Gallons; STB 794 Date

Pump Tank: 1000 Gallons; PT 27 Date

Pump Make: Zoeller Model W20-3-12/HA Serial No. A095039

Nitrification Field: No. Fields 1 Square Feet 532/798 Linear Feet 266

No. Lines 4@66 Trench Width 2-3' Max Trench Bottom Depth 3' Gravel Depth No

[X] New System [ ] Repair System Type: I, II, III, IV, V, VI

System Description: Pres Dosed - 16" PPBPS

Repair System Description: Some Type

Maintenance Agreement Required: [X] Yes [ ] No

[X] House/Mod. Home No. Bedrooms 4

[ ] Mobile Home No. Bathrooms 3.5

[ ] Business No. Employees

[ ] Other

[ ] Slab [X] Crawl Space [ ] Basement w/plumbing [ ] Basement wo/plumbing

Water Supply: [X] Individual [ ] Public [ ] Community


Comments:/Conditions:

Drainfield in Offsite Easement Area to 128


Comments:/Conditions:

(1" = 40')

INITIAL SITE SKETCH

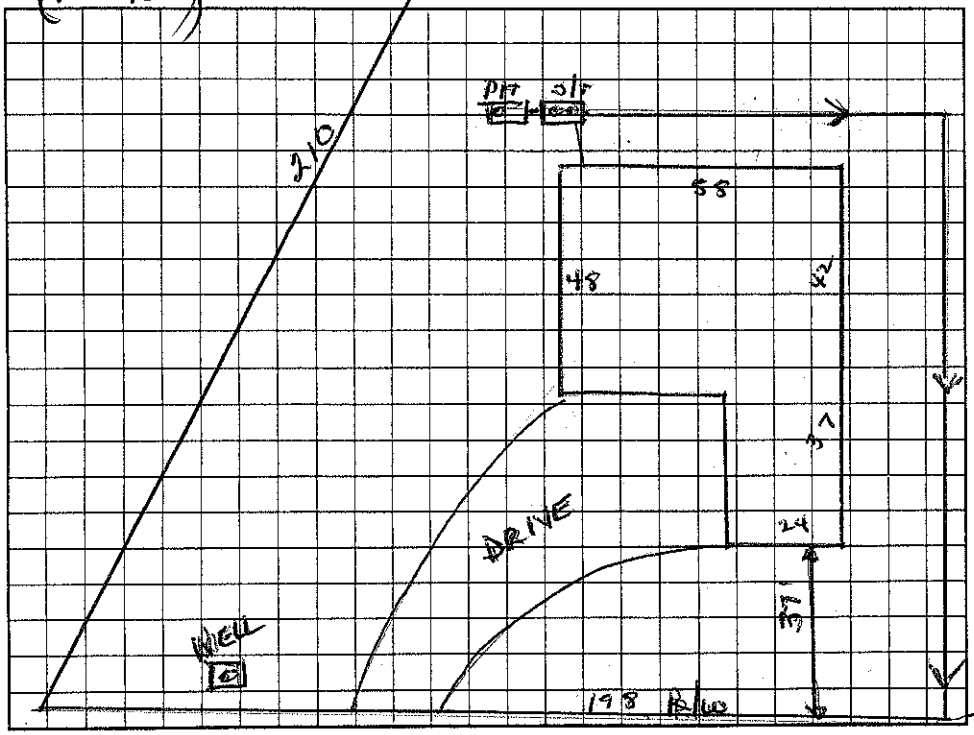

AS BUILT SKETCH

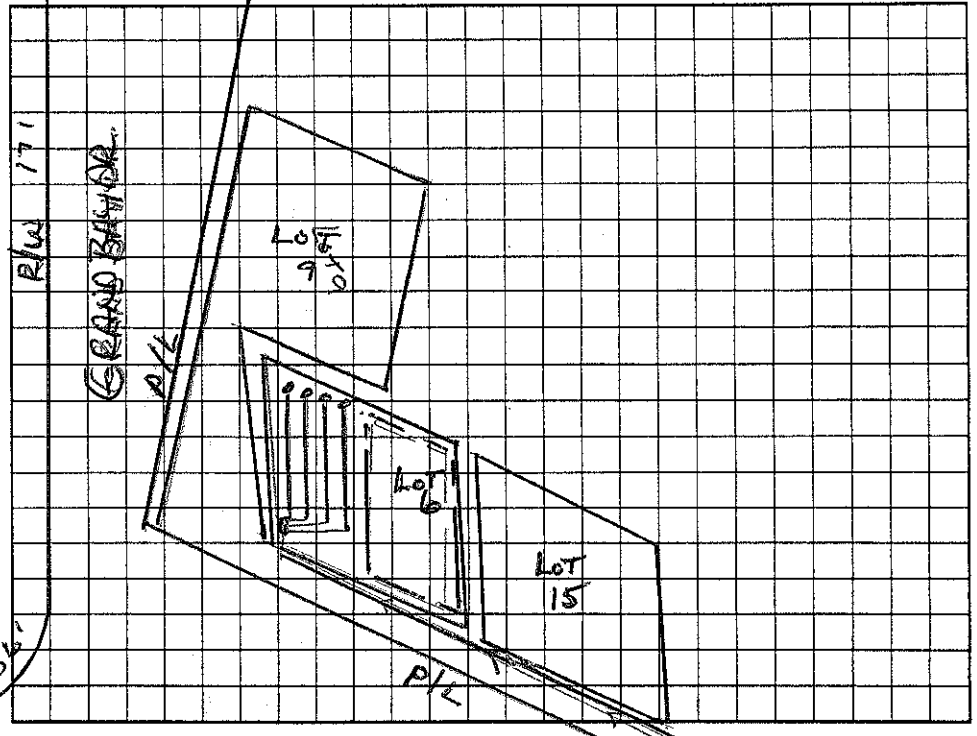

Permit can be suspended or revoked if any false information is supplied toward securing the permit/any unauthorized changes are made to the site/any unauthorized changes are made in the installation of the system. Improvement Permit with plat valid without expiration. Improvement Permit with site plan valid for sixty months. Authorization to Construct is valid for a period equal to that of Improvement Permit – not to exceed sixty months.

Signed: [signature] NORMANDY RD. date 8/11/04 Installed by: C+S Backhoe

Improvement Permit by: Wesley Sparks RS. date 8/9/04 Operation Permit by: Wesley Sparks RS date 6/22/05

Authorization to Construct by: Wesley Sparks RS. date 8/9/04 Existing System Inspection by: date

HEALTH DEPT. COPY: WHITE OWNER COPY (FINAL): YELLOW OWNER COPY (INITIAL): PINK