IREDELL COUNTY HEALTH DEPARTMENT

AUTHORIZATION TO CONSTRUCT

STATESVILLE 704-878-5305 MOORESVILLE 704-664-5281

IMPROVEMENT PERMIT / ~~CERTIFICATE OF COMPLETION~~ / OPERATION PERMIT / EXISTING SYSTEM INSPECTION

PROPERTY DESCRIPTION NO. 20644 DATE 12/20/96 TAX MAP NO. 2D-15-A-14 Watershed: ☑ Yes ☐ No

OWNER OR CONTRACTOR GRAND BAY DEV PHONE: Business 663-5115 ~~Home~~ PIN# 4638-73-5928

ADDRESS 166 CATAWBA AIR RD. MOORESVILLE 28115

LOCATION PEETH RD - TL NORMANDY - TR GRAND BAY DR - LAST LOT ON CT

SUBDIVISION GRAND BAY BLOCK / SECTION ____ LOT 11 LOT AREA ____ SITE CLASS. PS DESIGN FLOW 480 L.T.A.R. .36 GPD/FT

Septic Tank: 1000 Gallons; STB 794 Date 3/18/98

Pump Tank: ____ Gallons; PT ____ Date ____

Pump Make: ____ Model ____ Serial No. ____

Nitrification Field: No Fields 1 Square Feet 1200 Linear Feet 400

No Lines 3 Trench Width 36" Max Trench Bottom Depth 36" Gravel Depth N/A

☑ New System ☐ Repair System Type: I, II, (III) IV, V, VI

System Description: GRAVITY CHAMBERED

Repair System Description: PANEL

Maintenance Agreement Required: ☐ Yes ☑ No

☑ House/Mod. Home No. Bedrooms 4

☐ Mobile Home No. Bathrooms 4

☐ Business No. Employees ____

☐ Other ____


☐ Slab ☑ Crawl Space ☑ Basement w/plumbing ☐ Basement wo/plumbing

Water Supply: ☑ Individual ☐ Community ☐ Public


Comments: 82

Comments: (CLOSET WAS BOARDED UP TO MAKE 4BR) ~~3~~ 4

INITIAL SITE SKETCH (NOT TO SCALE)

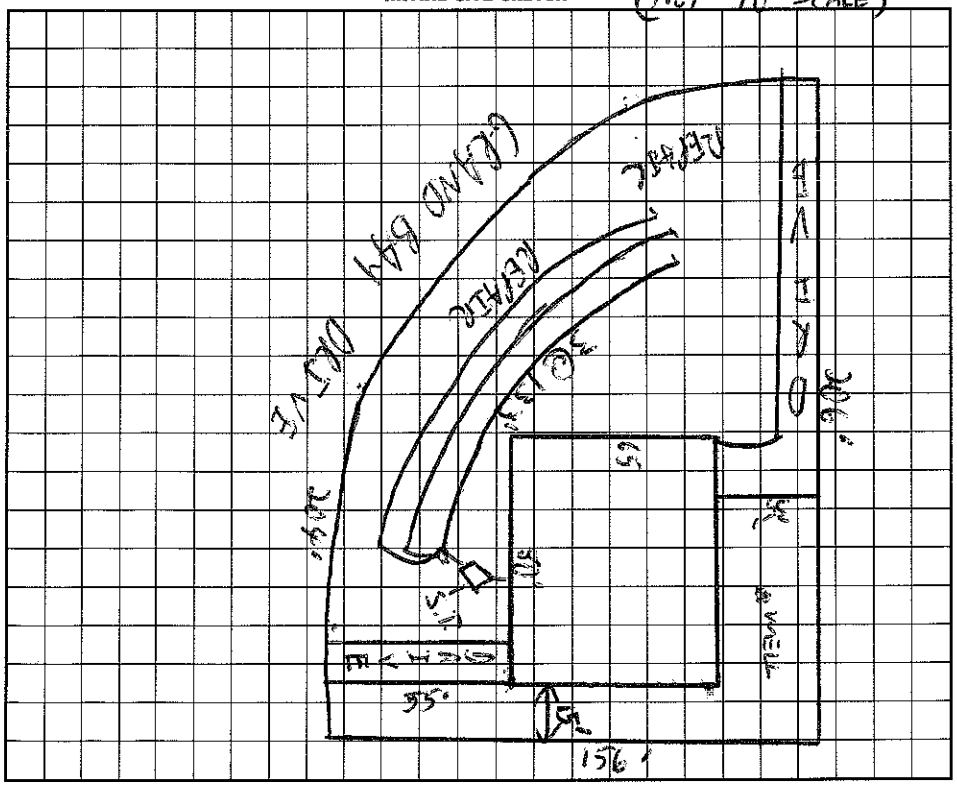

AS BUILT SKETCH

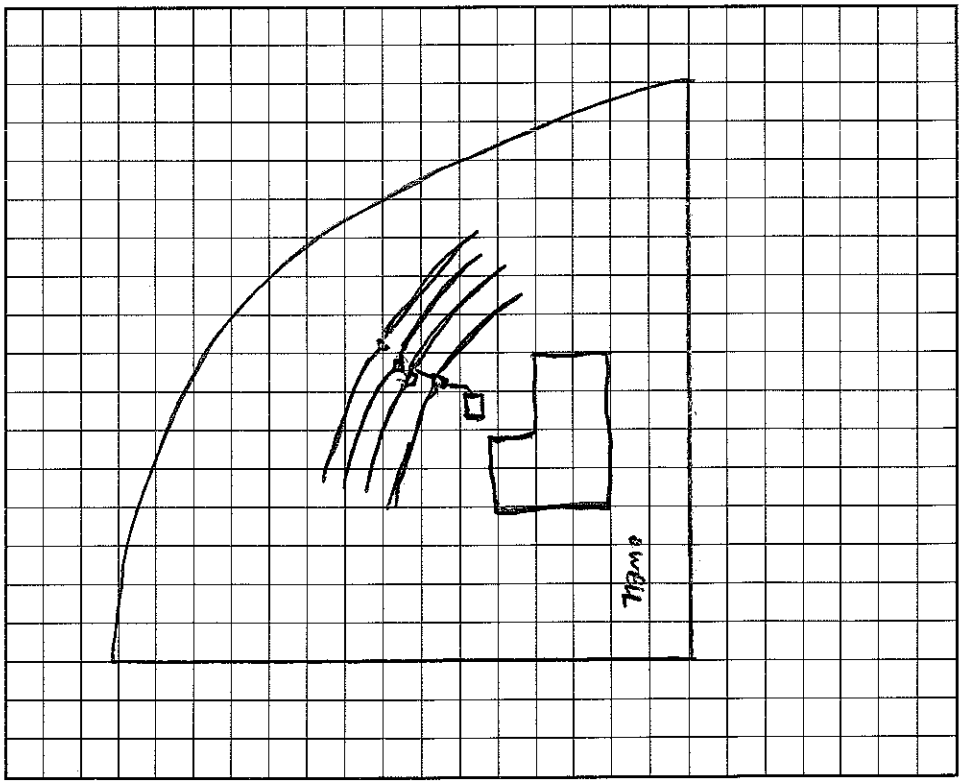

I understand that this permit can be suspended or revoked if any false information is supplied toward securing the permit/any unauthorized changes are made to the site/any unauthorized changes are made in the installation of the system.

Signed: Randy Mussey

Improvement Permit by: C. Blythe EHS date 12/20/96

~~Existing System Inspection by:~~ C. Blythe EHS date 12/20/96

AUTHORIZATION TO CONSTRUCT

Installed by: TIM AMMONS

Certificate of Completion by: ____ date ____

Operation Permit by: C. Blythe date 5/24/98

HEALTH DEPT. COPY: WHITE INSPECTION COPY (FINAL): GREEN OWNER COPY (FINAL): YELLOW INSPECTION COPY (INITIAL): PINK OWNER COPY (INITIAL): GOLD