IREDELL COUNTY HEALTH DEPARTMENT

STATESVILLE 704-878-5305 MOORESVILLE 704-664-5281

IMPROVEMENT PERMIT / AUTHORIZATION TO CONSTRUCT / OPERATION PERMIT / EXISTING SYSTEM INSPECTION

PERMIT# 20649 PIN# ~~ZP 75 A 19~~ 4638-73-6343 DATE 7/14/00

OWNER OR CONTRACTOR Ray Short PHONE: Business 309-7711 Home

ADDRESS 470 Stutts Rd. Mooresville, NC. 28117

LOCATION GRAND BAY DR, PERTH NTL NORMANDY TR GRAND BAY, R CORNER LOT

SUBDIVISION GRAND BAY BLOCK / SECTION LOT 19 LOT AREA .7 AC SITE CLASS. PS DESIGN FLOW 360 L.T.A.R. .3

Septic Tank: 1000 Gallons; STB 312 Date 1/13/01
Pump Tank: 1000 Gallons; PT 283 Date 1/19/01
Pump Make: Goulds Model WE0-5114 Serial No. 90157261
Nitrification Field: No Fields 1 Square Feet 600 Linear Feet 200
No Lines 3 or 4 Trench Width 36" Max Trench Bottom Depth 36" ~~Gravel Depth~~ 6" SAND

☒ New System ☐ Repair System Type: I, II, III, IV, V, VI
System Description: 16" PPBS - LPP Distribution
~~☒~~ Repair System Description: HDS or C.P. PLASTIC w/Pressure.
Maintenance Agreement Required: ☒ Yes ☐ No


☒ House/Mod. Home No. Bedrooms 3
☐ Mobile Home No. Bathrooms 3
☐ Business No. Employees
☐ Other
☐ Slab ☒ Crawl Space ☐ Basement w/plumbing ☐ Basement wo/plumbing

Water Supply: ☒ Individual ☐ Public ☐ Community

Comments:/Conditions: ~~☒~~ See Attachment for Repair Area Locations.

Comments:/Conditions:

(1" = 50') INITIAL SITE SKETCH

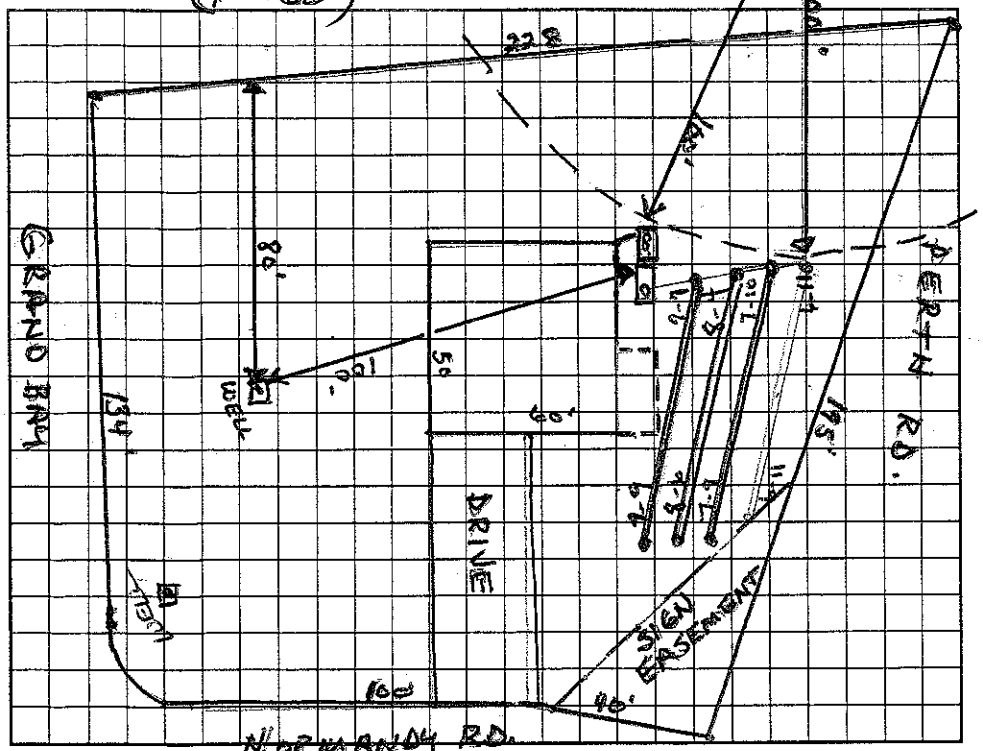

AS BUILT SKETCH

Permit can be suspended or revoked if any false information is supplied toward securing the permit/any unauthorized changes are made to the site/any unauthorized changes are made in the installation of the system. Improvement Permit with plat valid without expiration. Improvement Permit with site plan valid for sixty months. Authorization to Construct is valid for a period equal to that of Improvement Permit – not to exceed sixty months.

Signed: ~~☒~~ [signature] date 9/6/00 Installed by: Tommy Fryar

Improvement Permit by: Wesley Sparks RS. date 9/5/00 Operation Permit by: Wesley Sparks RS. date 4/16/01

Authorization to Construct by: Wesley Sparks RS date 9/5/00 Existing System Inspection by: date

HEALTH DEPT. COPY: WHITE OWNER COPY (FINAL): YELLOW OWNER COPY (INITIAL): PINK