4638-73-6467

IREDELL COUNTY HEALTH DEPARTMENT

STATESVILLE 704-878-5305 MOORESVILLE 704-664-5281

IMPROVEMENT PERMIT / CERTIFICATE OF COMPLETION / OPERATION PERMIT / EXISTING SYSTEM INSPECTI

PROPERTY DESCRIPTION NO. 20648 DATE 1/21/97 TAX MAP NO. 2P-15-A-18 Watershed: ☑ Yes ☐ No

OWNER OR CONTRACTOR GRAND BAY DEV / RAY SHORT PHONE: Business Home

ADDRESS 166 CATAWBA AIR RD

LOCATION PEETH RD - TR NORMANDY RD. TR GRAND BAY - 2nd LOT ON RT

SUBDIVISION GRAND BAY BLOCK / SECTION LOT 18 LOT AREA - SITE CLASS. PS DESIGN FLOW ~~480 GAL~~ 360 GPD L.T.A.R. .36 GPD/FT²

Septic Tank: 1000 Gallons; STB 825 Date 11-17-99

Pump Tank: Gallons; PT Date

Pump Make: Model Serial No.

Nitrification Field: No Fields 1 Square Feet ~~400~~ 400 Linear Feet ~~400~~ 300

No Lines ~~5 @ 80'~~ Trench Width 36" Max Trench Bottom Depth 36" Gravel Depth SAND

☑ New System ☐ Repair System Type: I, II, III IV, V, VI

System Description: GRAVITY CHAMBERED

Repair System Description: GRAVITY PANEL

Maintenance Agreement Required: ☐ Yes ☑ No

☑ House/Mod. Home ☐ Mobile Home ☐ Business ☐ Other

No. Bedrooms 3 No. Bathrooms 2.5 No. Employees


☐ Slab ☐ Crawl Space ☑ Basement w/plumbing ☐ Basement wo/plumbing

Water Supply: ☑ Individual ☐ Community ☐ Public


Comments: 4@75'

Comments:
APPROVED FOR 3BR BY BRADY FREEMAN.
WELL NOT INSTALLED AT TIME OF INSPECTION.

INITIAL SITE SKETCH 1"=60'

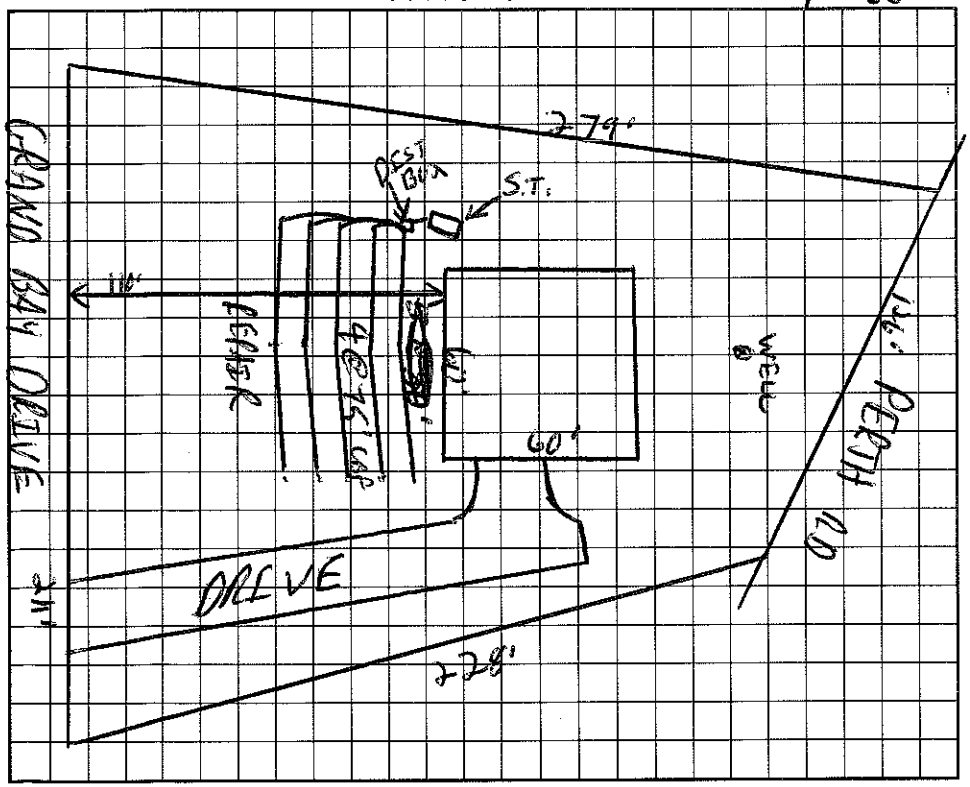

AS BUILT SKETCH

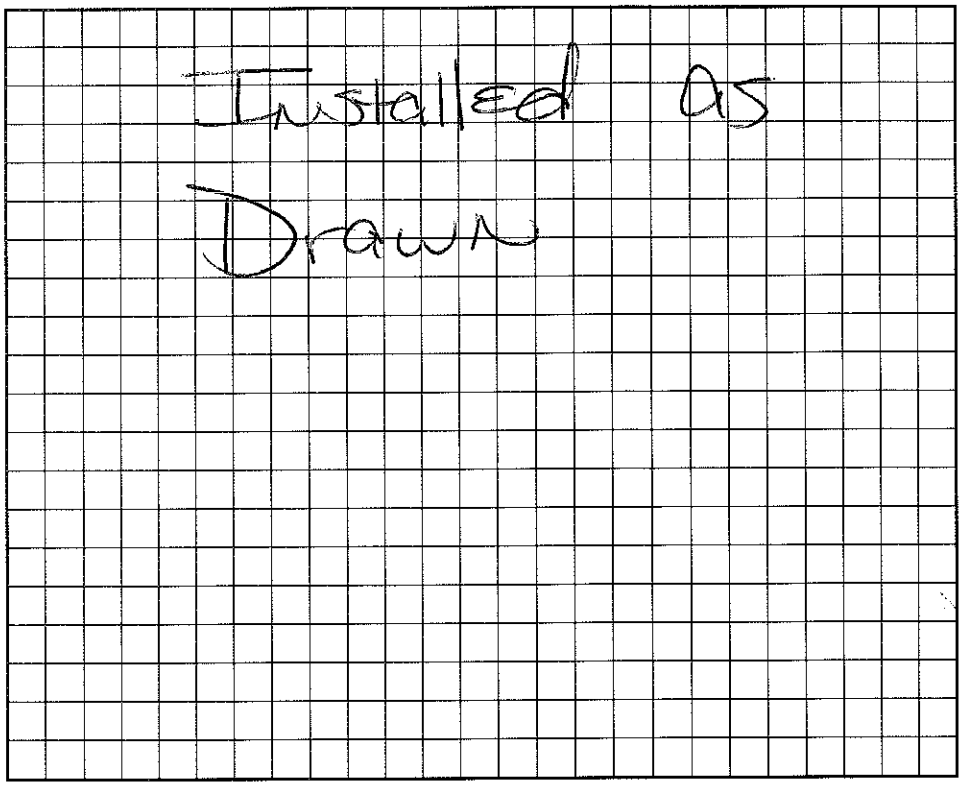

I understand that this permit can be suspended or revoked if any false information is supplied toward securing the permit/any unauthorized changes are made to the site/any unauthorized changes are made in the installation of the system. Improvement Permit is valid for 60 months from date of issuance.

Signed: Kamela Murray / My Short 9/7/99

Improvement Permit by: C. [illegible] date 1/21/97

Existing System Inspection by: C. [illegible] date 7/26/99

Installed by: Wayne Clontz

Certificate of Completion by: Marie H. Dotson RS date 2/22/2000

Operation Permit by: Marie H. Dotson RS date 2/22/2000

HEALTH DEPT. COPY: WHITE INSPECTION COPY (FINAL): GREEN OWNER COPY (FINAL): YELLOW INSPECTION COPY (INITIAL): PINK OWNER COPY (INITIAL): GOLD