4638-73-6558

4-12

IREDELL COUNTY HEALTH DEPARTMENT

STATESVILLE 704-878-5305 MOORESVILLE 704-664-5281

IMPROVEMENT PERMIT / ~~CERTIFICATE OF COMPLETION~~ / OPERATION PERMIT / EXISTING SYSTEM INSPECTION

PROPERTY DESCRIPTION NO. 20647 DATE 1/20/97 TAX MAP NO. 2P-15-A-17 Watershed: ☑ Yes ☐ No

OWNER OR CONTRACTOR GRAND BAY DEV. PHONE: Business 663-5115 Home

ADDRESS 166 CATAWBA AIR RD MOORESVILLE NC 28115

LOCATION PERTH RD - TL NORMANDY - TR GRAND BAY - 3RD LOT ON RT

SUBDIVISION GRAND BAY BLOCK / SECTION LOT 17 LOT AREA SITE CLASS. PS DESIGN FLOW 480GPD L.T.A.R. .35 GPD/FT²

Septic Tank: 1600 Gallons; STB 1007 Date 10/14/00

Pump Tank: Gallons; PT Date

Pump Make: Model Serial No.

Nitrification Field: No Fields 1 Square Feet 684 Linear Feet 228

No Lines 4@57' Trench Width 24" Max Trench Bottom Depth 36" Gravel Depth N/A

☑ New System ☐ Repair System Type: I, II, (III), IV, V, VI

System Description: GRAVITY PANEL

Repair System Description: SAME

Maintenance Agreement Required: ☐ Yes ☑ No

☑ House/Mod. Home No. Bedrooms 4

☐ Mobile Home No. Bathrooms 2.5

☐ Business No. Employees

☐ Other

☐ Slab ☐ Crawl Space ☑ Basement w/plumbing ☐ Basement wo/plumbing


Water Supply: ☑ Individual ☐ Community ☐ Public

Comments:


Comments:

INITIAL SITE SKETCH

1" = 50'

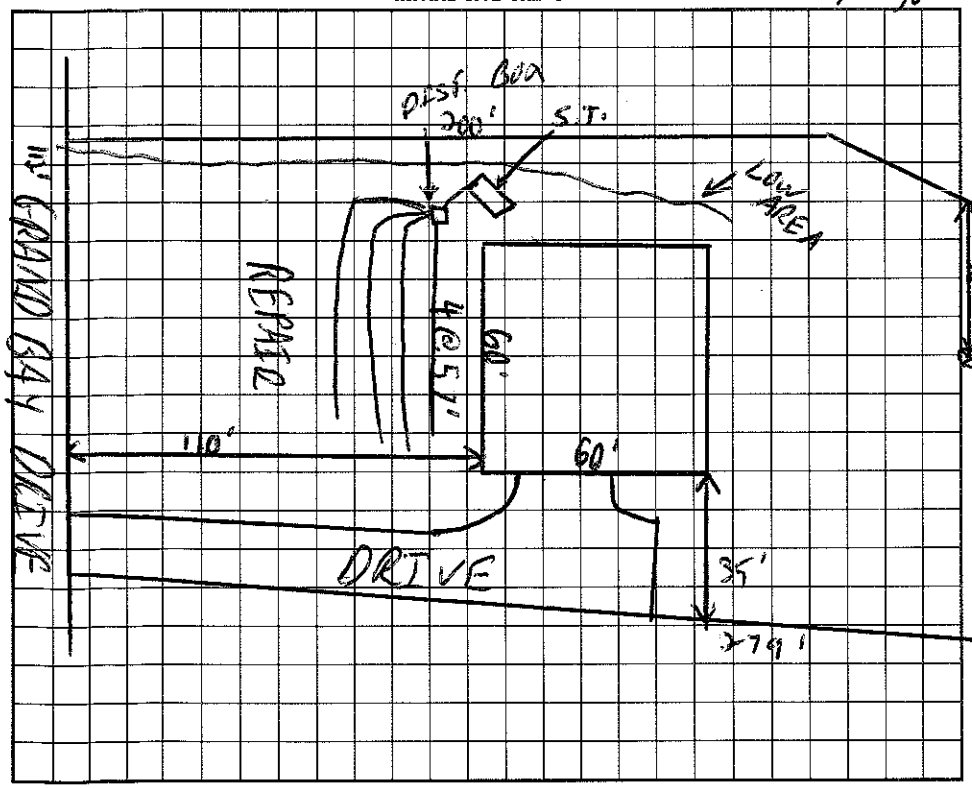

AS BUILT SKETCH

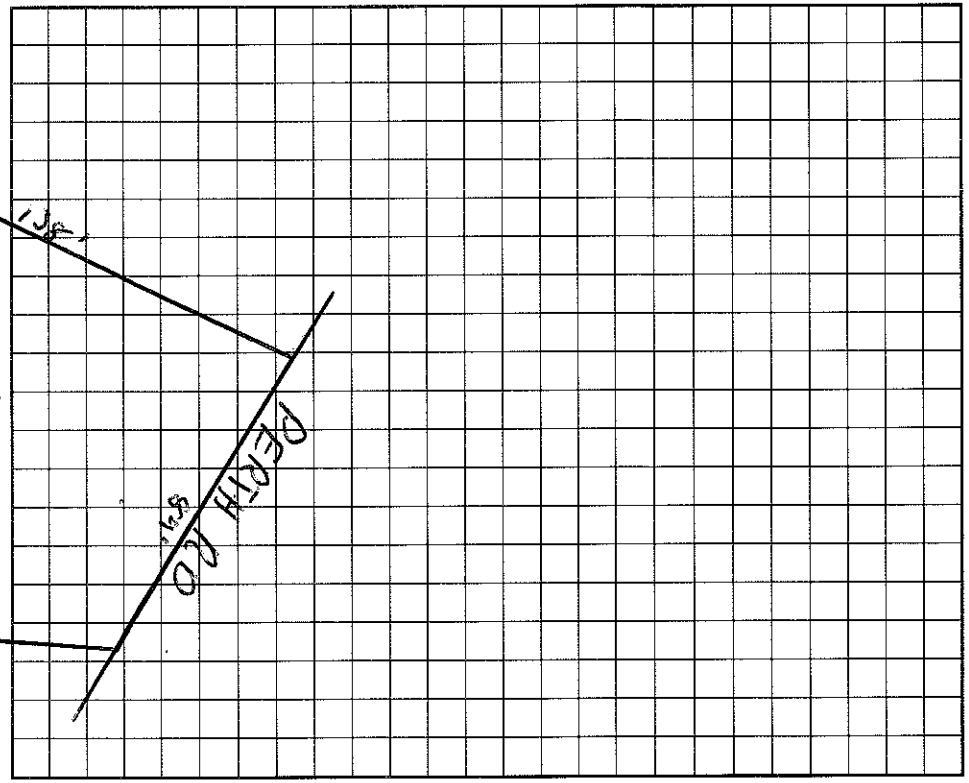

I understand that this permit can be suspended or revoked if any false information is supplied toward securing the permit/any unauthorized changes are made to the site/any unauthorized changes are made in the installation of the system. Improvement Permit is valid for 60 months from date of issuance.

Signed: Randy Murray

Improvement Permit by: C. Blythe EHS date 1/21/97

Existing System Inspection by: C. Blythe PS date 6/28/00

Installed by: Advanced - Backhoe

Certificate of Completion by: [illegible] RSI date 2-20-01

Operation Permit by: date

HEALTH DEPT. COPY: WHITE INSPECTION COPY (FINAL): GREEN OWNER COPY (FINAL): YELLOW INSPECTION COPY (INITIAL): PINK OWNER COPY (INITIAL): GOLD