Permit# 77413

IREDELL COUNTY HEALTH DEPARTMENT

STATESVILLE 704-878-5305 MOORESVILLE 704-664-5281

IMPROVEMENT PERMIT / AUTHORIZATION TO CONSTRUCT / OPERATION PERMIT / EXISTING SYSTEM INSPECTION

PERMIT# 20646 PIN# 2P-15-A-16 4638 73 6722 DATE 3/30/99

OWNER OR CONTRACTOR ALEX MARSHALL PHONE: Business Home

ADDRESS 166 CATAWBA AVE OC.

LOCATION 150 W. TO PERTH - TL NORMANDY - TR GRAND BAY DR. ON RT

SUBDIVISION GRAND BAY BLOCK / SECTION 2 LOT 16 LOT AREA SITE CLASS. PS DESIGN FLOW 480 L.T.A.R. .35 0-10/PT2

Septic Tank: 1000 Gallons; STB 749 Date 11/20/98

Pump Tank: 1000 Gallons; PT 27 Date /

Pump Make: Model Serial No.

Nitrification Field: No Fields 1 Square Feet 1080 Linear Feet @ 360

No Lines 6@60' Trench Width 36" Max Trench Bottom Depth 36" Gravel Depth N/A

☑ New System ☐ Repair System Type: I, II, (III), IV, V, VI

System Description: PUMP EZFLO OR CHAMBER

Repair System Description: OFF SITE PANEL

Maintenance Agreement Required: ☐ Yes ☑ No

☑ House/Mod. Home No. Bedrooms 4

☐ Mobile Home No. Bathrooms 4

☐ Business No. Employees

☐ Other


☐ Slab ☐ Crawl Space ☑ Basement w/plumbing ☐ Basement wo/plumbing

Water Supply: ☑ Individual ☐ Public ☐ Community

Comments:/Conditions:

Comments:/Conditions:

INITIAL SITE SKETCH

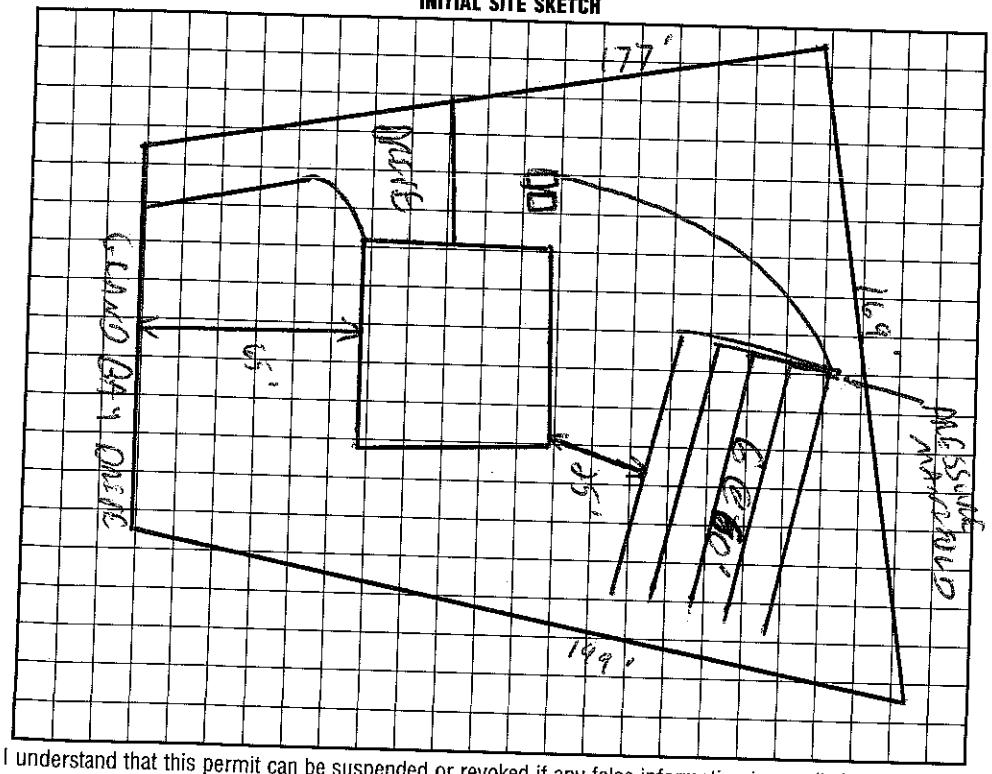

AS BUILT SKETCH

I understand that this permit can be suspended or revoked if any false information is supplied toward securing the permit/any unauthorized changes are made to the site/any unauthorized changes are made in the installation of the system. Improvement Permit with plat valid without expiration. Improvement Permit with site plan valid for sixty months. Authorization to Construct is valid for a period equal to that of Improvement Permit – not to exceed sixty months.

Signed: date

Improvement Permit by: C. Myers RS date 3/30/99

Authorization to Construct by: C. Myers RS date 3/30/99

Installed by: STANLEY SEPTIC

Operation Permit by: C. Myers RS date 6/17/99

Existing System Inspection by: date

HEALTH DEPT. COPY: WHITE INSPECTION COPY (FINAL): GREEN OWNER COPY (FINAL): YELLOW INSPECTION COPY (INITIAL): PINK OWNER COPY (INITIAL): GOLD