# IREDELL COUNTY HEALTH DEPARTMENT

STATESVILLE 704-878-5305 MOORESVILLE 704-664-5281

## IMPROVEMENT PERMIT / CERTIFICATE OF COMPLETION / OPERATION PERMIT / EXISTING SYSTEM INSPECTION

PROPERTY DESCRIPTION NO. 20633 DATE 7/3/95 TAX MAP NO. ~~2P 15 A 11~~ 4638-74-3123 Watershed: ☒ Yes ☐ No

OWNER OR CONTRACTOR Grand Bay Dev. Corp PHONE: Business 663-5115 Home

ADDRESS 166 Catawba Rd. Mooresville, NC 28115

LOCATION Normandy Rd. TR Grand Bay

SUBDIVISION Grand Bay BLOCK / SECTION LOT 11 LOT AREA SITE CLASS. DESIGN FLOW 400 L.T.A.R. 3

Septic Tank: 1000 Gallons; STB 794 Date 11/30/95

Pump Tank: 1000 Gallons; PT 49 Date 11/22/95

Pump Make: Davis Model WFC712 Serial No. ~~300~~ (533)

Nitrification Field: No Fields 1 Square Feet 1600 Linear Feet ~~300~~ (533)

No Lines 4 Trench Width 24 Max Trench Bottom Depth 28" Gravel Depth 6" Stone

☒ New System ☐ Repair System Type: I, II, III, ☒ V, VI

System Description: Pressure Panel 16"

Repair System Description: Same

Maintenance Agreement Required: ☒ Yes ☐ No

☒ House/Mod. Home No. Bedrooms 4

☐ Mobile Home No. Bathrooms 3

☐ Business No. Employees

☐ Other


☐ Slab ☒ Crawl Space ☐ Basement w/plumbing ☐ Basement wo/plumbing

Water Supply: ☒ Individual ☐ Community ☐ Public


Comments: ~~X~~ 16" Pressure Panel - 4 @ 75' x 2'
3/16" hole per panel, turned up inside panel -
2' pressure hand at end of each lateral -
High water alarm. 4 panels ~ 164 gallons per dose pump Min 31 gallons/min.

Comments: (K 9541340 - Pump Serial #)
Driveway must not cause Repair Area -

INITIAL SITE SKETCH

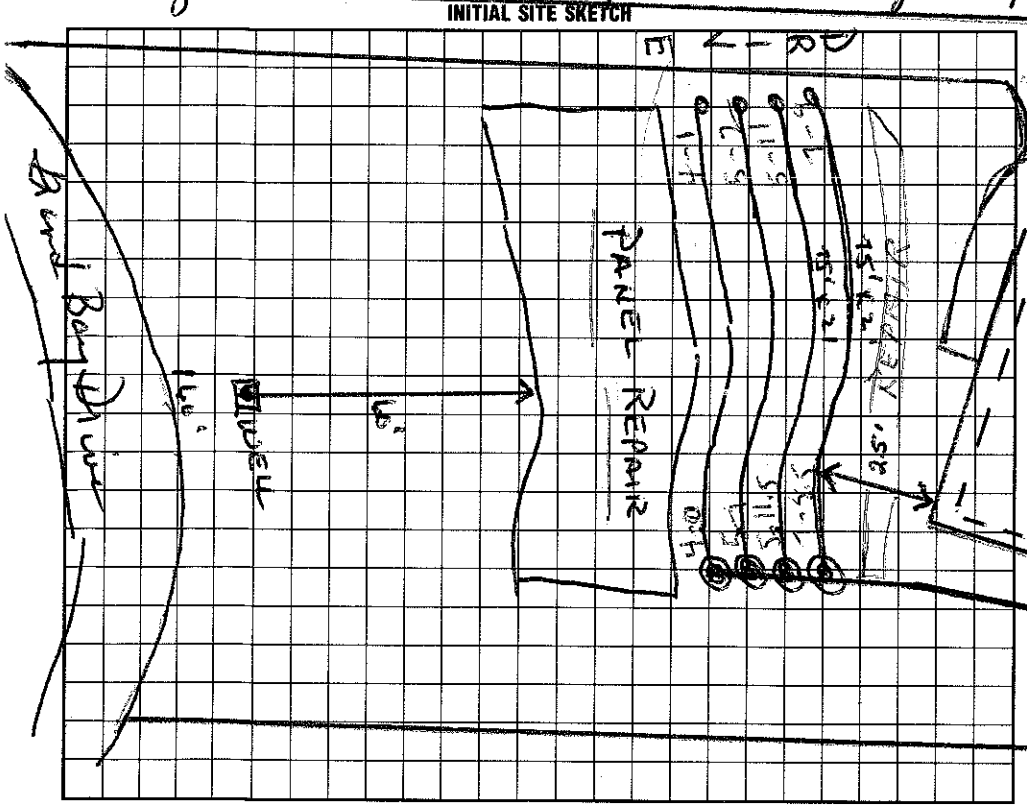


AS BUILT SKETCH

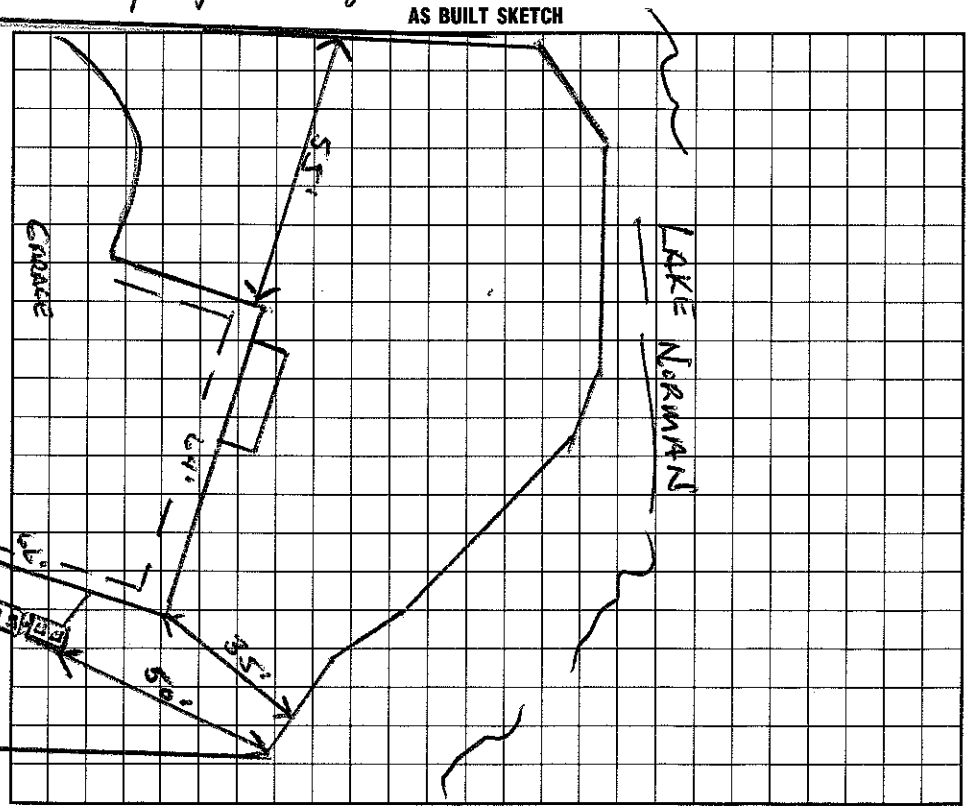


I understand that this permit can be suspended or revoked if any false information is supplied toward securing the permit/any unauthorized changes are made to the site/any unauthorized changes are made in the installation of the system. Improvement Permit is valid for 60 months from date of issuance.

Signed: X Landowner

Improvement Permit by: Wesley Sparks R.S. date 7/3/95

Existing System Inspection by: date

Installed by: F J Erwin

Certificate of Completion by: date

Operation Permit by: Wesley Sparks R.S. date 4/1/96

HEALTH DEPT. COPY: WHITE INSPECTION COPY (FINAL): GREEN OWNER COPY (FINAL): YELLOW INSPECTION COPY (INITIAL): PINK OWNER COPY (INITIAL): GOLD