IREDELL COUNTY HEALTH DEPARTMENT

STATESVILLE 704-878-5305 MOORESVILLE 704-664-5281

IMPROVEMENT PERMIT / CERTIFICATE OF COMPLETION / OPERATION PERMIT / EXISTING SYSTEM INSPECTION

PROPERTY DESCRIPTION NO. 20633 DATE 7/3/95 TAX MAP NO. 2P 15 A 11 Watershed: [X] Yes, [ ]

OWNER OR CONTRACTOR Grand Bay Dev. Corp PHONE: Business 663-5115 Home

ADDRESS 1166 Catawba Rd. Mooresville, NC 28115

LOCATION Normandy Rd. TR Grand Bay

SUBDIVISION Grand Bay BLOCK / SECTION LOT 11 LOT AREA SITE CLASS. DESIGN FLOW 480 L.T.A.R. .3

Septic Tank: 1000 Gallons; STB 794 Date 11/30/95

Pump Tank: 1000 Gallons; PT 47 Date 11/22/95

Pump Make: Deuld Model WE0712 Serial No. ~~300~~

Nitrification Field: No Fields 1 Square Feet 1600 Linear Feet ~~600~~ (533)

No Lines 4 Trench Width 24 Max Trench Bottom Depth 28" Gravel Depth 6" Stone

[X] New System [ ] Repair System Type: I, II, III, (IV) V, VI

System Description: Pressure Panel 16"

Repair System Description: Same

Maintenance Agreement Required: [X] Yes [ ] No

[X] House/Mod. Home No. Bedrooms 4

[ ] Mobile Home No. Bathrooms 3

[ ] Business No. Employees

[ ] Other


[ ] Slab [X] Crawl Space [ ] Basement w/plumbing [ ] Basement wo/plumbing

Water Supply: [X] Individual [ ] Communi [ ] Public


Comments: [X] 16" Pressure Panel - 4 @ 75' x 2' 3/16" hole per panel, turned upside panel - 2' pressure hood at end of each lateral - High water alarm. 4 panels ~ 164 gallons per zone pump Min 31 gallons/min.

Comments: (K 954134C - Pump Serial #) Drive way must not cross Repair Area -

INITIAL SITE SKETCH

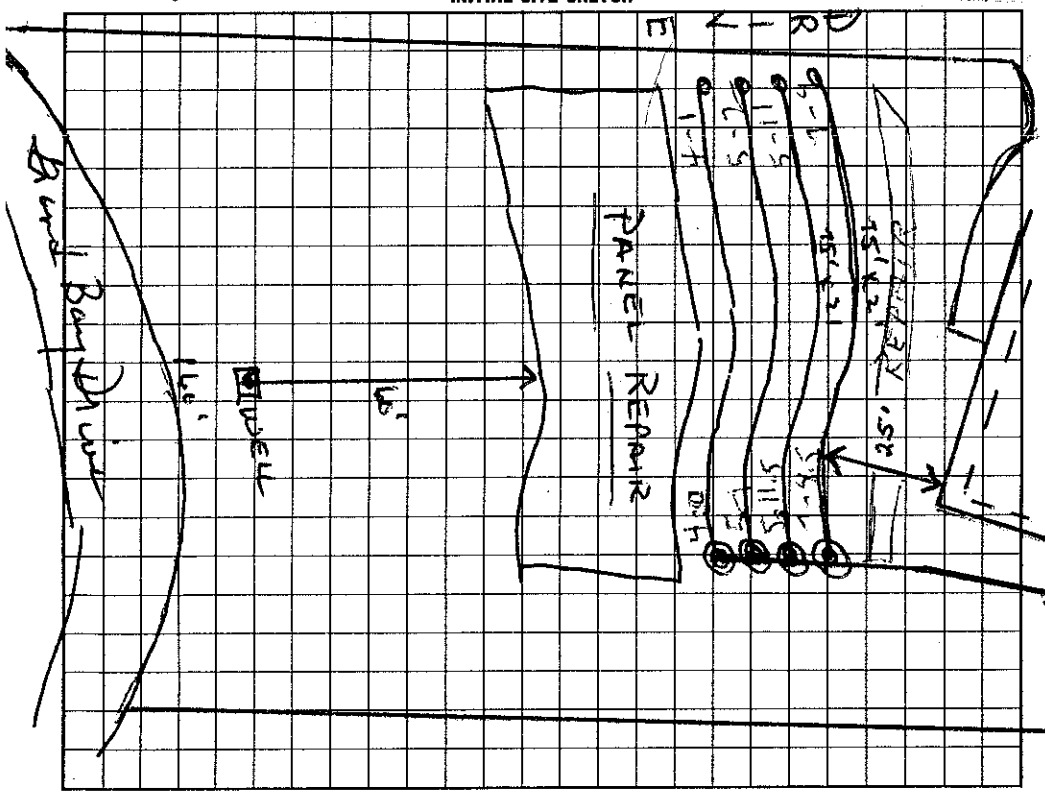

AS BUILT SKETCH

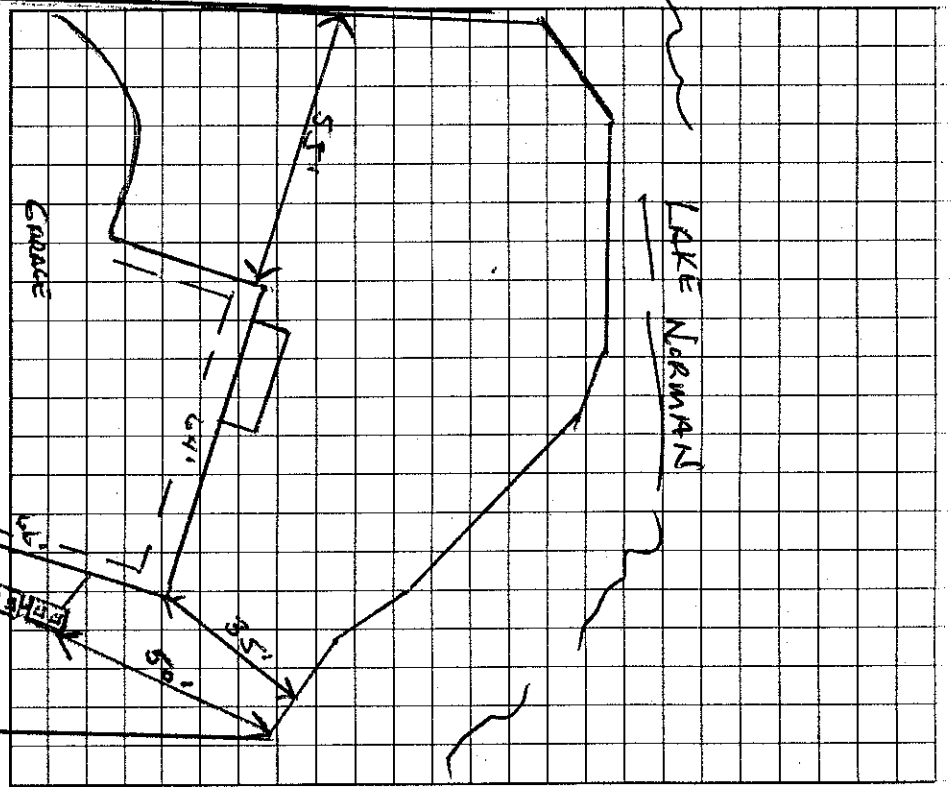

I understand that this permit can be suspended or revoked if any false information is supplied toward securing the permit/any unauthorized changes are made to the site/any unauthorized changes are made in the installation of the system. Improvement Permit is valid for 60 months from date of issuance.

Signed: X Randy Murray

Improvement Permit by: Wesley Sparks R.S. date 7/3/95

Existing System Inspection by: date

Installed by: F J Erwin

Certificate of Completion by: date

Operation Permit by: Wesley Sparks R.S. date 4/1/96

HEALTH DEPT. COPY: WHITE INSPECTION COPY (FINAL): GREEN OWNER COPY (FINAL): YELLOW INSPECTION COPY (INITIAL): PINK OWNER COPY (INITIAL): GOLD