4638-74-3259

IREDELL COUNTY HEALTH DEPARTMENT

STATESVILLE 704-878-5305 MOORESVILLE 704-664-5281

IMPROVEMENT PERMIT / CERTIFICATE OF COMPLETION / OPERATION PERMIT / EXISTING SYSTEM INSPECTION

PROPERTY DESCRIPTION NO. 20642 DATE 9/26/95 TAX MAP NO. 2P-15-A-12 Watershed: [X] Yes [ ] No

OWNER OR CONTRACTOR Brend Bay Development Corp. PHONE: Business 663-5115 Home

ADDRESS 166 Cartwheel Rd. Mooresville NC. 28115

LOCATION Peth Rd. (L) on Normandy Rd. TR Brend Bay to 4th lot (L)

SUBDIVISION Brend Bay BLOCK / SECTION LOT 12 LOT AREA 1.15 Ac SITE CLASS. PS DESIGN FLOW 480 L.T.A.R. .3

Septic Tank: 1000 Gallons; STB 794 Date 12/28/95

Pump Tank: Gallons; PT Date

Pump Make: Model Serial No.

Nitrification Field: No Fields 1 Square Feet 1200 Linear Feet 248

No Lines 5 Trench Width 24" Max Trench Bottom Depth 30" Gravel Depth 6" STONE

[X] New System [ ] Repair System Type: I, II, (III), IV, V, VI

System Description: GRAVPANEL

Repair System Description: PRESSURE PANEL

Maintenance Agreement Required: [X] Yes [ ] No

[X] House/Mod. Home No. Bedrooms 4

[ ] Mobile Home No. Bathrooms 3

[ ] Business No. Employees

[ ] Other


[ ] Slab [ ] Crawl Space [X] Basement w/plumbing [ ] Basement wo/plumbing

Water Supply: [X] Individual [ ] Community [ ] Public


Comments: X See attached plat for basement area to be used for repair space on lower (R) corner of Amenity Area.

Comments: L2 248

INITIAL SITE SKETCH

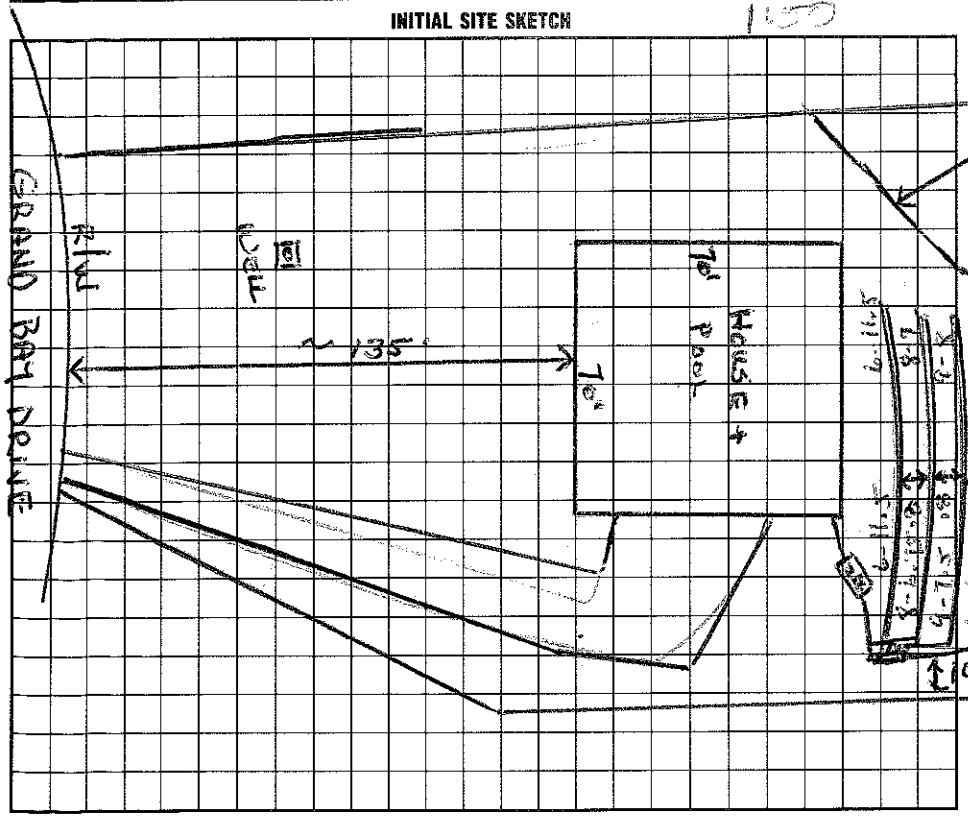

AS BUILT SKETCH

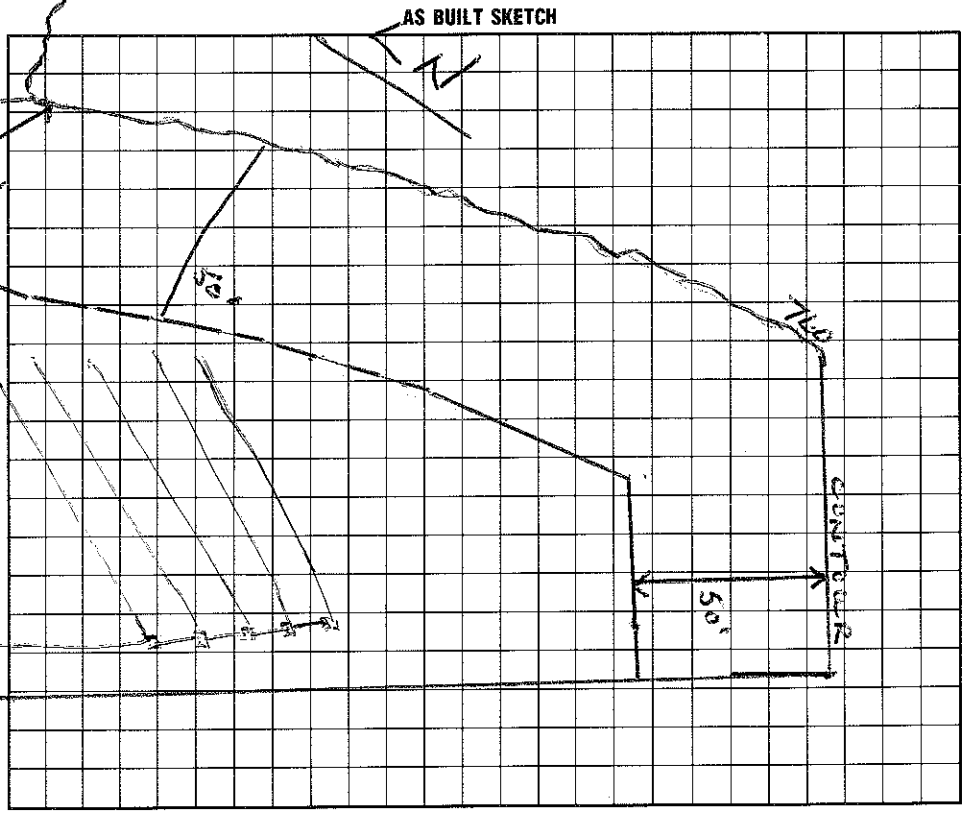

I understand that this permit can be suspended or revoked if any false information is supplied toward securing the permit/any unauthorized changes are made to the site/any unauthorized changes are made in the installation of the system.

Signed: Randy Murray

Improvement Permit by: Wesley Sparks RS. date 9/26/95

Existing System Inspection by: date

Installed by: F J Erwin

Certificate of Completion by: Wesley Sparks RS. date 2/23/96

Operation Permit by: Wesley Sparks RS. date 2/23/96

HEALTH DEPT. COPY: WHITE INSPECTION COPY (FINAL): GREEN OWNER COPY (FINAL): YELLOW INSPECTION COPY (INITIAL): PINK OWNER COPY (INITIAL): GOLD