IREDELL COUNTY HEALTH DEPARTMENT

STATESVILLE 704-878-5305 MOORESVILLE 704-664-5281

IMPROVEMENT PERMIT / CERTIFICATE OF COMPLETION / OPERATION PERMIT / EXISTING SYSTEM INSPECTION

PROPERTY DESCRIPTION NO. 20642 DATE 9/26/95 TAX MAP NO. 2P-15-A-12 Watershed: [X] Yes [ ] No

OWNER OR CONTRACTOR Grand Bay Development Corp. PHONE: Business 663-5115 Home

ADDRESS 166 Cotswold Rd. Mooresville, NC. 28115

LOCATION Perth Rd. (L) on Normandy Rd. TR Grand Bay to 4th lot (L)

SUBDIVISION Grand Bay BLOCK / SECTION LOT 12 LOT AREA 1.15 Ac SITE CLASS. PS DESIGN FLOW 480 L.T.A.R. .3

Septic Tank: 1000 Gallons; STB 794 Date 12/28/95
Pump Tank: Gallons; PT Date
Pump Make: Model Serial No.
Nitrification Field: No Fields 1 Square Feet 1200 Linear Feet 248
No Lines 5 Trench Width 24" Max Trench Bottom Depth 30" Gravel Depth 16" STONE

[X] New System [ ] Repair System Type: I, II, (III), IV, V, VI
System Description: GRAVPANEL
Repair System Description: PRESSURE PANEL
Maintenance Agreement Required: [X] Yes [ ] No


[X] House/Mod. Home No. Bedrooms 4
[ ] Mobile Home No. Bathrooms 3
[ ] Business No. Employees
[ ] Other
[ ] Slab [ ] Crawl Space [X] Basement w/plumbing [ ] Basement wo/plumbing

Water Supply:
[X] Individual
[ ] Community
[ ] Public


Comments: X See attached plat for easement area to be used for repair space. on lower (R) corner of Community Area.

Comments: L2 4 248

INITIAL SITE SKETCH

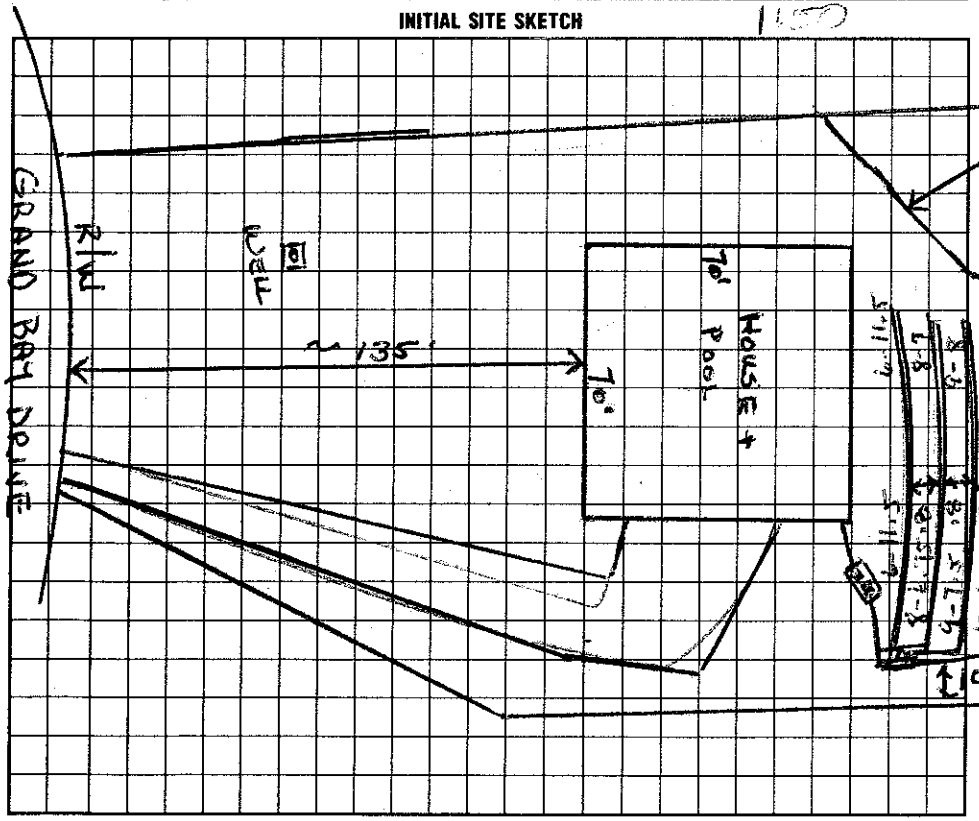

AS BUILT SKETCH

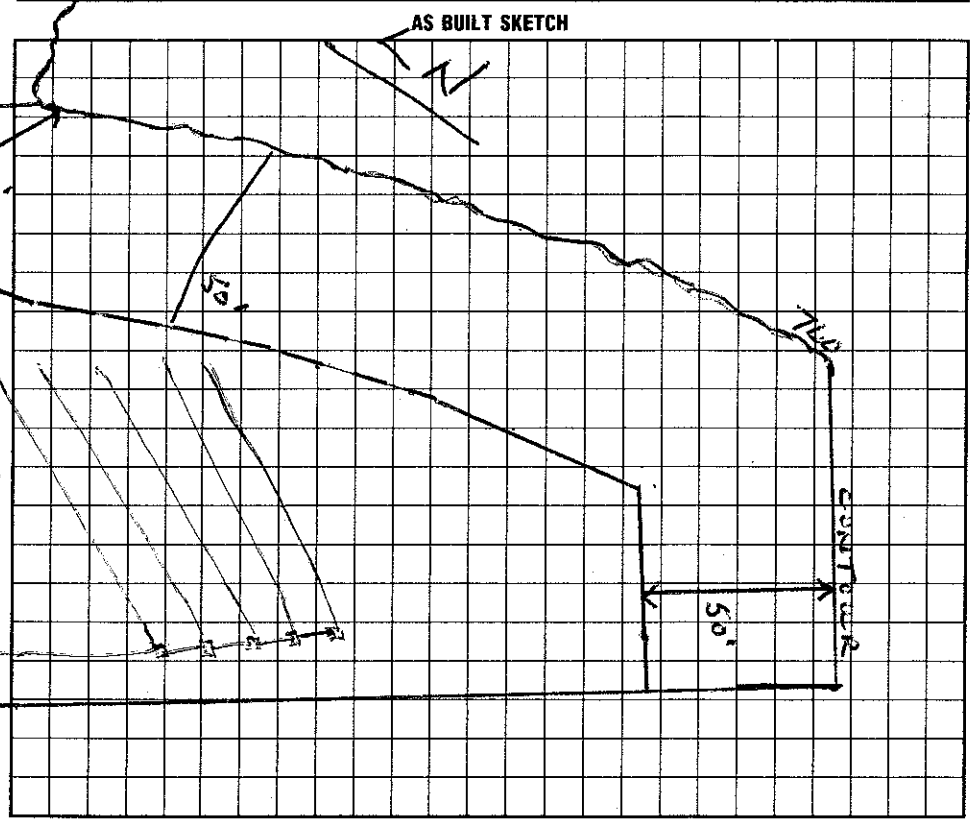

I understand that this permit can be suspended or revoked if any false information is supplied toward securing the permit/any unauthorized changes are made to the site/any unauthorized changes are made in the installation of the system.

Signed: Randy Murray

Improvement Permit by: Wesley Sparks RS. date 9/26/95

Existing System Inspection by: date

Installed by: F J Ervin

Certificate of Completion by: Wesley Sparks RS. date 2/23/96

Operation Permit by: Wesley Sparks RS. date 2/23/96

HEALTH DEPT. COPY: WHITE INSPECTION COPY (FINAL): GREEN OWNER COPY (FINAL): YELLOW INSPECTION COPY (INITIAL): PINK OWNER COPY (INITIAL): GOLD