IREDELL COUNTY HEALTH DEPARTMENT / Authorization to Construct

STATESVILLE 704-878-5305 MOORESVILLE 704-664-5281

4638751786

IMPROVEMENT PERMIT / ~~CERTIFICATE OF COMPLETION~~ / OPERATION PERMIT / EXISTING SYSTEM INSPECTION

PROPERTY DESCRIPTION NO. 22495 DATE 1/20/96 TAX MAP NO. 2S 3 A 40 Watershed: X Yes ☐ No

OWNER OR CONTRACTOR Sonny + Lonnie Morton PHONE: Business _____ Home 375-2340

ADDRESS 1921 E 8th St. Charlotte NC. 28204

LOCATION 207 Hideaway Ln. Perth Rd N X first bridge Tr Hideaway ~1/3 mile on (L)

SUBDIVISION CL+T BLOCK / SECTION 14 LOT 40 LOT AREA ~.8Ac SITE CLASS. PS DESIGN FLOW 480 L.T.A.R. .35

Septic Tank: 1000 Gallons; STB _____ Date _____

Pump Tank: _____ Gallons; PT _____ Date _____

Pump Make: _____ Model _____ Serial No. _____

Nitrification Field: No Fields 1 Square Feet 600 Linear Feet 200

No Lines 2 Trench Width 36" Max Trench Bottom Depth 36"

X New System ☐ Repair System Type: I. II. (III) IV. V. VI

System Description: Add to EX. SYSTEM

Repair System Description: _____

Maintenance Agreement Required: ☐ Yes X No

Gravel Depth 6" SAND ☐ Slab ☐ Crawl Space X Basement w/plumbing ☐ Basement wo/plumbing

X House/Mod. Home No. Bedrooms 4

☐ Mobile Home No. Bathrooms 3.5

☐ Business No. Employees _____


☐ Other _____

Water Supply: X Individual ☐ Community ☐ Public

Comments: 200 feet of gravity flow Effluent to gator
Flow devider required before D/B's
Sand backfill to top of panel louvers

Comments:

INITIAL SITE SKETCH

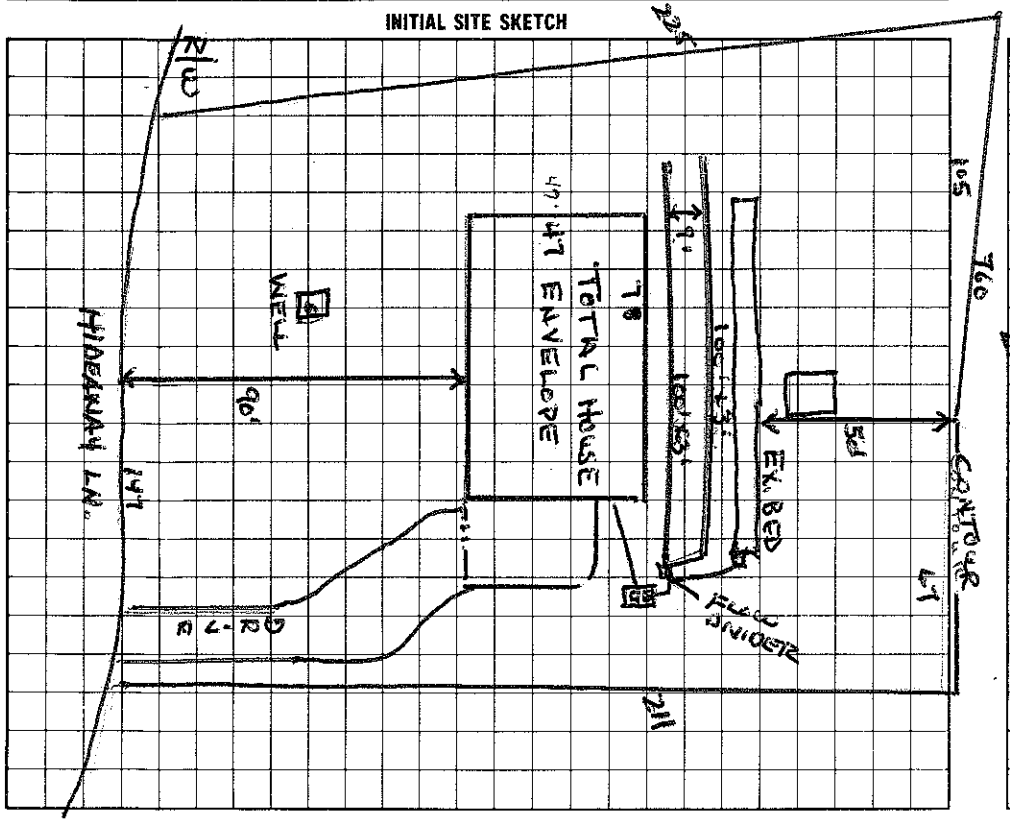

AS BUILT SKETCH

I understand that this permit can be suspended or revoked if any false information is supplied toward securing the permit/any unauthorized changes are made to the site/any unauthorized changes are made in the installation of the system.

Signed: Sonny Morton

Improvement Permit by: Wesley Sparks RS. date 1/22/96

Authorization to Construct by: Wesley Sparks RS. date 1/22/96

Installed by: Orbison Const.

Certificate of Completion by: Wesley Sparks RS. date 12/5/97

Operation Permit by: Wesley Sparks RS. date 12/5/97

HEALTH DEPT. COPY: WHITE INSPECTION COPY (FINAL): GREEN OWNER COPY (FINAL): YELLOW INSPECTION COPY (INITIAL): PINK OWNER COPY (INITIAL): GOLD