IREDELL COUNTY HEALTH DEPARTMENT

→ AUTHORIZATION TO CONSTRUCT 4638761022 9-39

STATESVILLE 704-878-5305 MOORESVILLE 704-664-5281

IMPROVEMENT PERMIT / ~~CERTIFICATE OF COMPLETION~~ / OPERATION PERMIT / EXISTING SYSTEM INSPECTION

PROPERTY DESCRIPTION NO. 23239 DATE 10/18/96 TAX MAP NO. lot of 25A 80 Watershed: ☑ Yes ☐ No

OWNER OR CONTRACTOR VICTOR JONES PHONE: Business 596-8333 (AGENT) Home

ADDRESS 11829 REAMES RD - CHARLOTTE NC 28269 ED MOONEY

LOCATION 150 W TR PERTH RD - TL HIDEAWAY LN ON RT

SUBDIVISION HARBORVIEW BLOCK / SECTION 1 LOT 18 LOT AREA .690C SITE CLASS. PS DESIGN FLOW 480GPD L.T.A.R. .36-PD/FT²

Septic Tank: 1000 Gallons; STB 794 Date 3-14-97

Pump Tank: ____ Gallons; PT ____ Date ____

Pump Make: ____ Model ____ Serial No. ____

Nitrification Field: No Fields 1 Square Feet 1200 Linear Feet 400

No Lines 4 Trench Width 36" Max Trench Bottom Depth ≈24" Gravel Depth N/A

☑ New System ☐ Repair System Type: I, II, (III) IV, V, VI

System Description: GRAVITY CHAMBERED ORSINIM

Repair System Description: PANEL

Maintenance Agreement Required: ☐ Yes ☑ No

☑ House/Mod. Home ☐ Mobile Home ☐ Business ☐ Other

No. Bedrooms 4 No. Bathrooms 2.5 No. Employees ____


☑ Slab ⊡ Crawl Space ☐ Basement w/plumbing ☐ Basement wo/plumbing

Water Supply: ☐ Individual ☑ Community ☐ Public

Comments:

Comments:

INITIAL SITE SKETCH 1"=60'

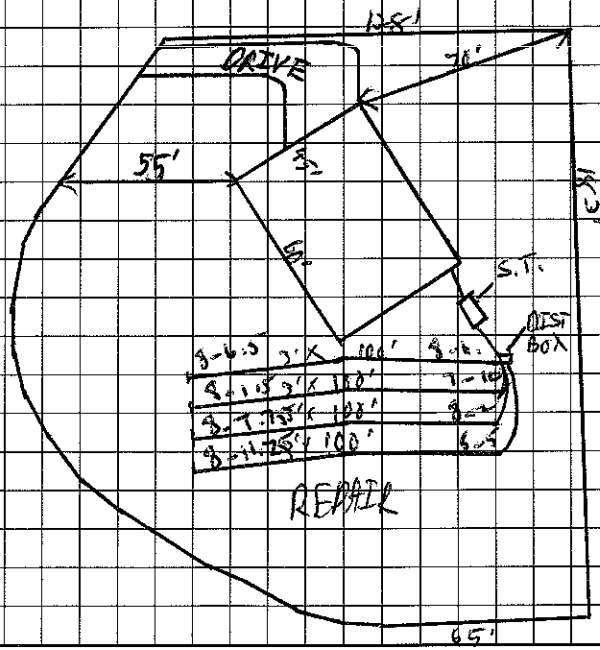

AS BUILT SKETCH

I understand that this permit can be suspended or revoked if any false information is supplied toward securing the permit/any unauthorized changes are made to the site/any unauthorized changes are made in the installation of the system.

Signed: Edward McCracken

Improvement Permit by: C. Gary Graves date 10/18/96

AUTHORIZATION TO CONSTRUCT Existing System Inspection by: C. Gary Graves date 10/18/96

Installed by: Tim Ammons

Certificate of Completion by: Wesley Sparks RS. date 6/5/97

Operation Permit by: Wesley Sparks RS. date 6/5/97

HEALTH DEPT. COPY: WHITE INSPECTION COPY (FINAL): GREEN OWNER COPY (FINAL): YELLOW INSPECTION COPY (INITIAL): PINK OWNER COPY (INITIAL): GOLD