IREDELL COUNTY HEALTH DEPARTMENT

AUTHORIZATION TO CONSTRUCT

STATESVILLE 704-878-5305 MOORESVILLE 704-664-5281

IMPROVEMENT PERMIT / ~~CERTIFICATE OF COMPLETION~~ / OPERATION PERMIT / EXISTING SYSTEM INSPECTI

PROPERTY DESCRIPTION NO. 23236 DATE 7/22/96 TAX MAP NO. pt of 2SA80 4638 762137 Watershed: ☑ Yes ☐ No

OWNER OR CONTRACTOR CHERYL GRAHAM PHONE: Business Home 664-4758

ADDRESS 108 TARA LYNN DR. MOORESVILLE NC 28115

LOCATION 150 W - TR PERTH RD - TL HIDEAWAY LANE - LOT ON RIGHT

SUBDIVISION HARBORVIEW BLOCK / SECTION 1 LOT 15 LOT AREA .65 AC SITE CLASS. PS DESIGN FLOW 300GAD L.T.A.R. .3 GPD/FT2

Septic Tank: 1000 Gallons; STB 1012 Date 10/22/96

Pump Tank: 1000 Gallons; PT 17 Date 8/27/96

Pump Make: Model Serial No.

Nitrification Field: No Fields 1 Square Feet 1200 Linear Feet 400

No Lines 4 Trench Width 36" Max Trench Bottom Depth 36" Gravel Depth 12"

☑ New System ☐ Repair System Type: I, II, III, IV, V, VI

System Description: PUMP CONVENTIONAL

Repair System Description: PUMP CHAMBERED

Maintenance Agreement Required: ☐ Yes ☑ No

☑ House/Mod. Home No. Bedrooms 3

☐ Mobile Home No. Bathrooms 2.5

☐ Business No. Employees

☐ Other


☐ Slab ☑ Crawl Space ☐ Basement w/plumbing ☐ Basement wo/plumbing

Water Supply: ☐ Individual ☑ Community ☐ Public


Comments:

Comments: LINES TANKS CHECKED 12/5/96. CRF

INITIAL SITE SKETCH 1" = 60'

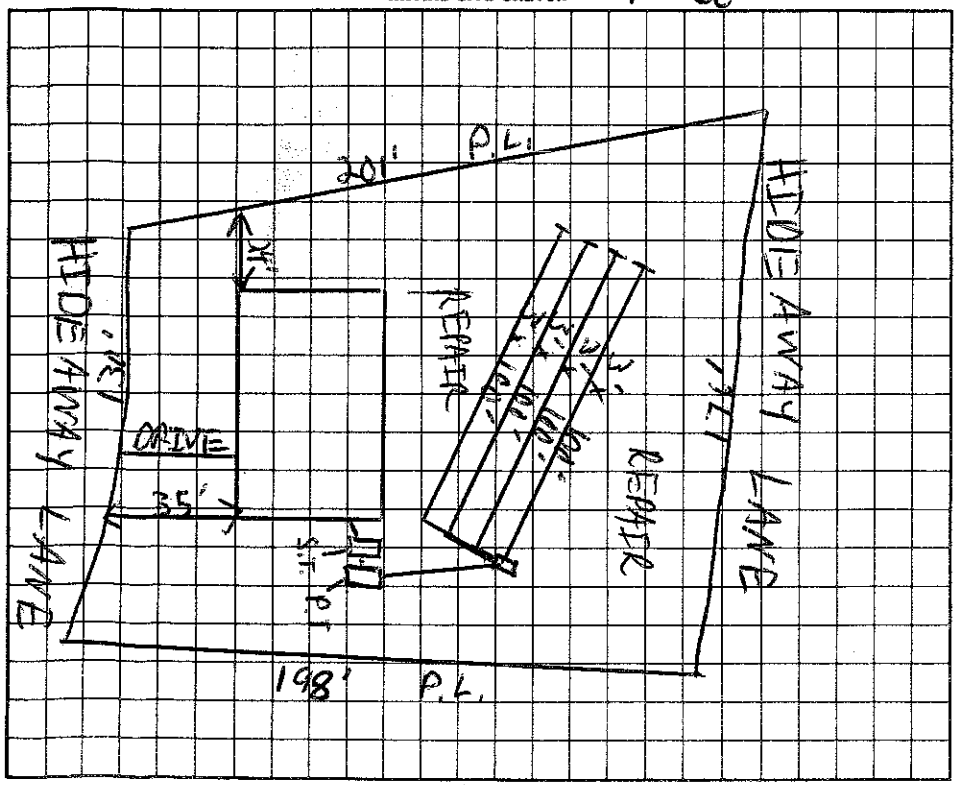

AS BUILT SKETCH

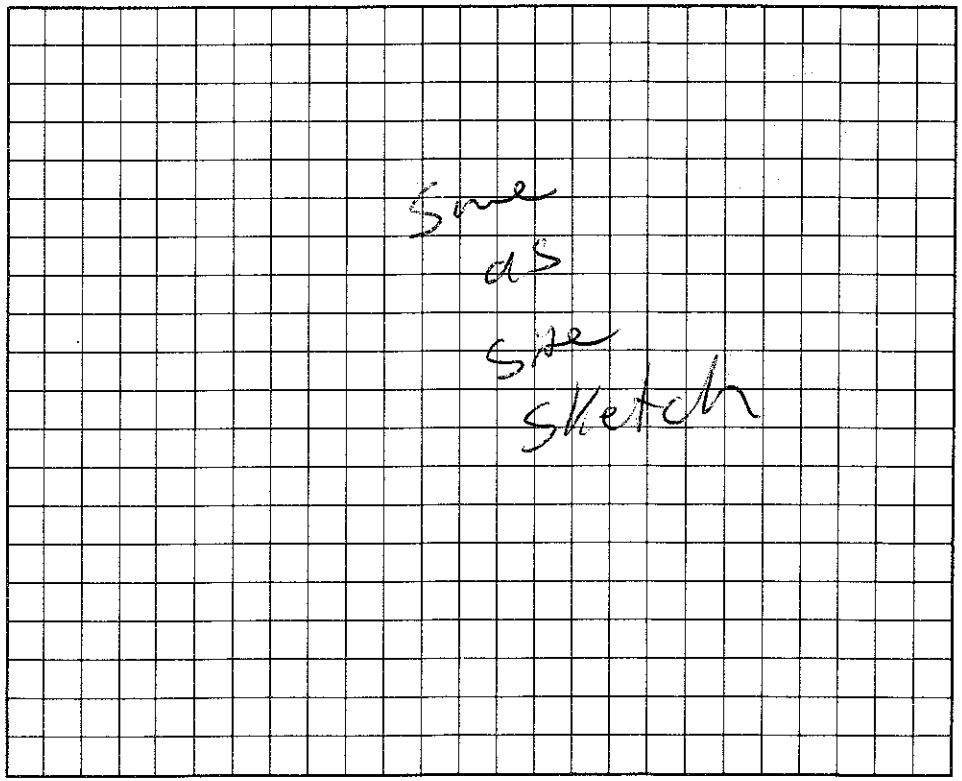

I understand that this permit can be suspended or revoked if any false information is supplied toward securing the permit/any unauthorized changes are made to the site/any unauthorized changes are made in the installation of the system.

Signed: Cheryl Graham

Installed by: ABER NATHY

Improvement Permit by: C. Robby Foster EHSI date 7/22/96

Existing System Inspection by: C. Robby Foster EHSI date 7/22/96

Certificate of Completion by: date

Operation Permit by: C. Robby Foster date 3/27/97

CONSTRUCTION AUTHORIZATION

HEALTH DEPT. COPY: WHITE INSPECTION COPY (FINAL): GREEN OWNER COPY (FINAL): YELLOW INSPECTION COPY (INITIAL): PINK OWNER COPY (INITIAL): GOLD

AUTHORIZATION TO CONSTRUCT IS VALID FOR 60 MONTHS FROM ISSUE DATE.