IREDELL COUNTY HEALTH DEPARTMENT

Statesville Office (704) 878-5305 Mooresville Office (704) 660-3625

PERMIT # 207319

IMPROVEMENT PERMIT / AUTHORIZATION TO CONSTRUCT / OPERATION PERMIT / EXISTING SYSTEM

PIN # 4638765776

APPLICANT: Wendel Overby/Beason Gen Cont APPLICANT ADDRESS: P.O. Box 832 Mooresville, NC 28117

SITE ADDRESS: 160 Hideaway Ln Mooresville, NC 28117 PHONE: 704 746-5046 ALT. PHONE:

SITE DIRECTIONS: Hwy 150 W JR Perth Rd TL Hideaway Ln lot on Right

SUBDIVISION: Harborview/Herring Bay SECTION: -1- LOT # 10 LOT AREA: 1.13 Ac DESIGN FLOW: 480gpd L.T.A.R.: .3

Septic Tank 1000 (gal) STB 794 Date 1-29-16
Pump Tank 1000 (gal) PT 283 Date 3-7-16
Pump Make Goulds Model WE07J2H Serial #
Nitrification Fields 1 # Lines 5 Linear Ft: 267'
Trench Width min 24" Max. Trench Bottom Depth 30" Gravel Depth N/A

☒ New System ☐ Repair ☐ Expansion System Type: I II III (IV) V VI
System Description: LP PPBPS
Repair System Description: Drip Irrigation
Maintenance Agreement Required: ☒ YES ☐ NO
☐ GRAVITY ☒ PRESSURE

☒ Residence No. Bedrooms 4
☐ Business No. Persons 8
☐ Other No. Employees
☐ Slab ☒ Crawl Space
☐ Basement w/plumbing ☐ Basement w/o plumbing

Water Supply: ☐ Private ☐ Public ☒ Community

Comments / Conditions:

4/18/16 Checked tanks, lines, set pressure
Checked valve box

INITIAL SITE SKETCH

See attached/approved plan by ~~Soil~~ RollansSoil & Environmental (dated 2-15-16, approved 3/2/16)

AS BUILT SKETCH

	Date	Initials
Drain Lines Checked	4/18/16	MD
Tanks Checked	4/18/16	MD
Pressure Manifold or Valve Box Checked	4/18/16	MD
Pressure Head Set	4/18/16	MD
Electrical Checked	8-4	BA
Floats Set	4/18/16	MD
Alarm Checked	8-4	BA
Maintenance Contract (Y) / N	8-4-16	BA

Permit can be suspended or revoked if any false information is supplied toward securing the permit / any unauthorized changes are made to the site / any unauthorized changes are made in the installation of the system. **CONTACT A LOCATOR SERVICE PRIOR TO ANY EXCAVATION**

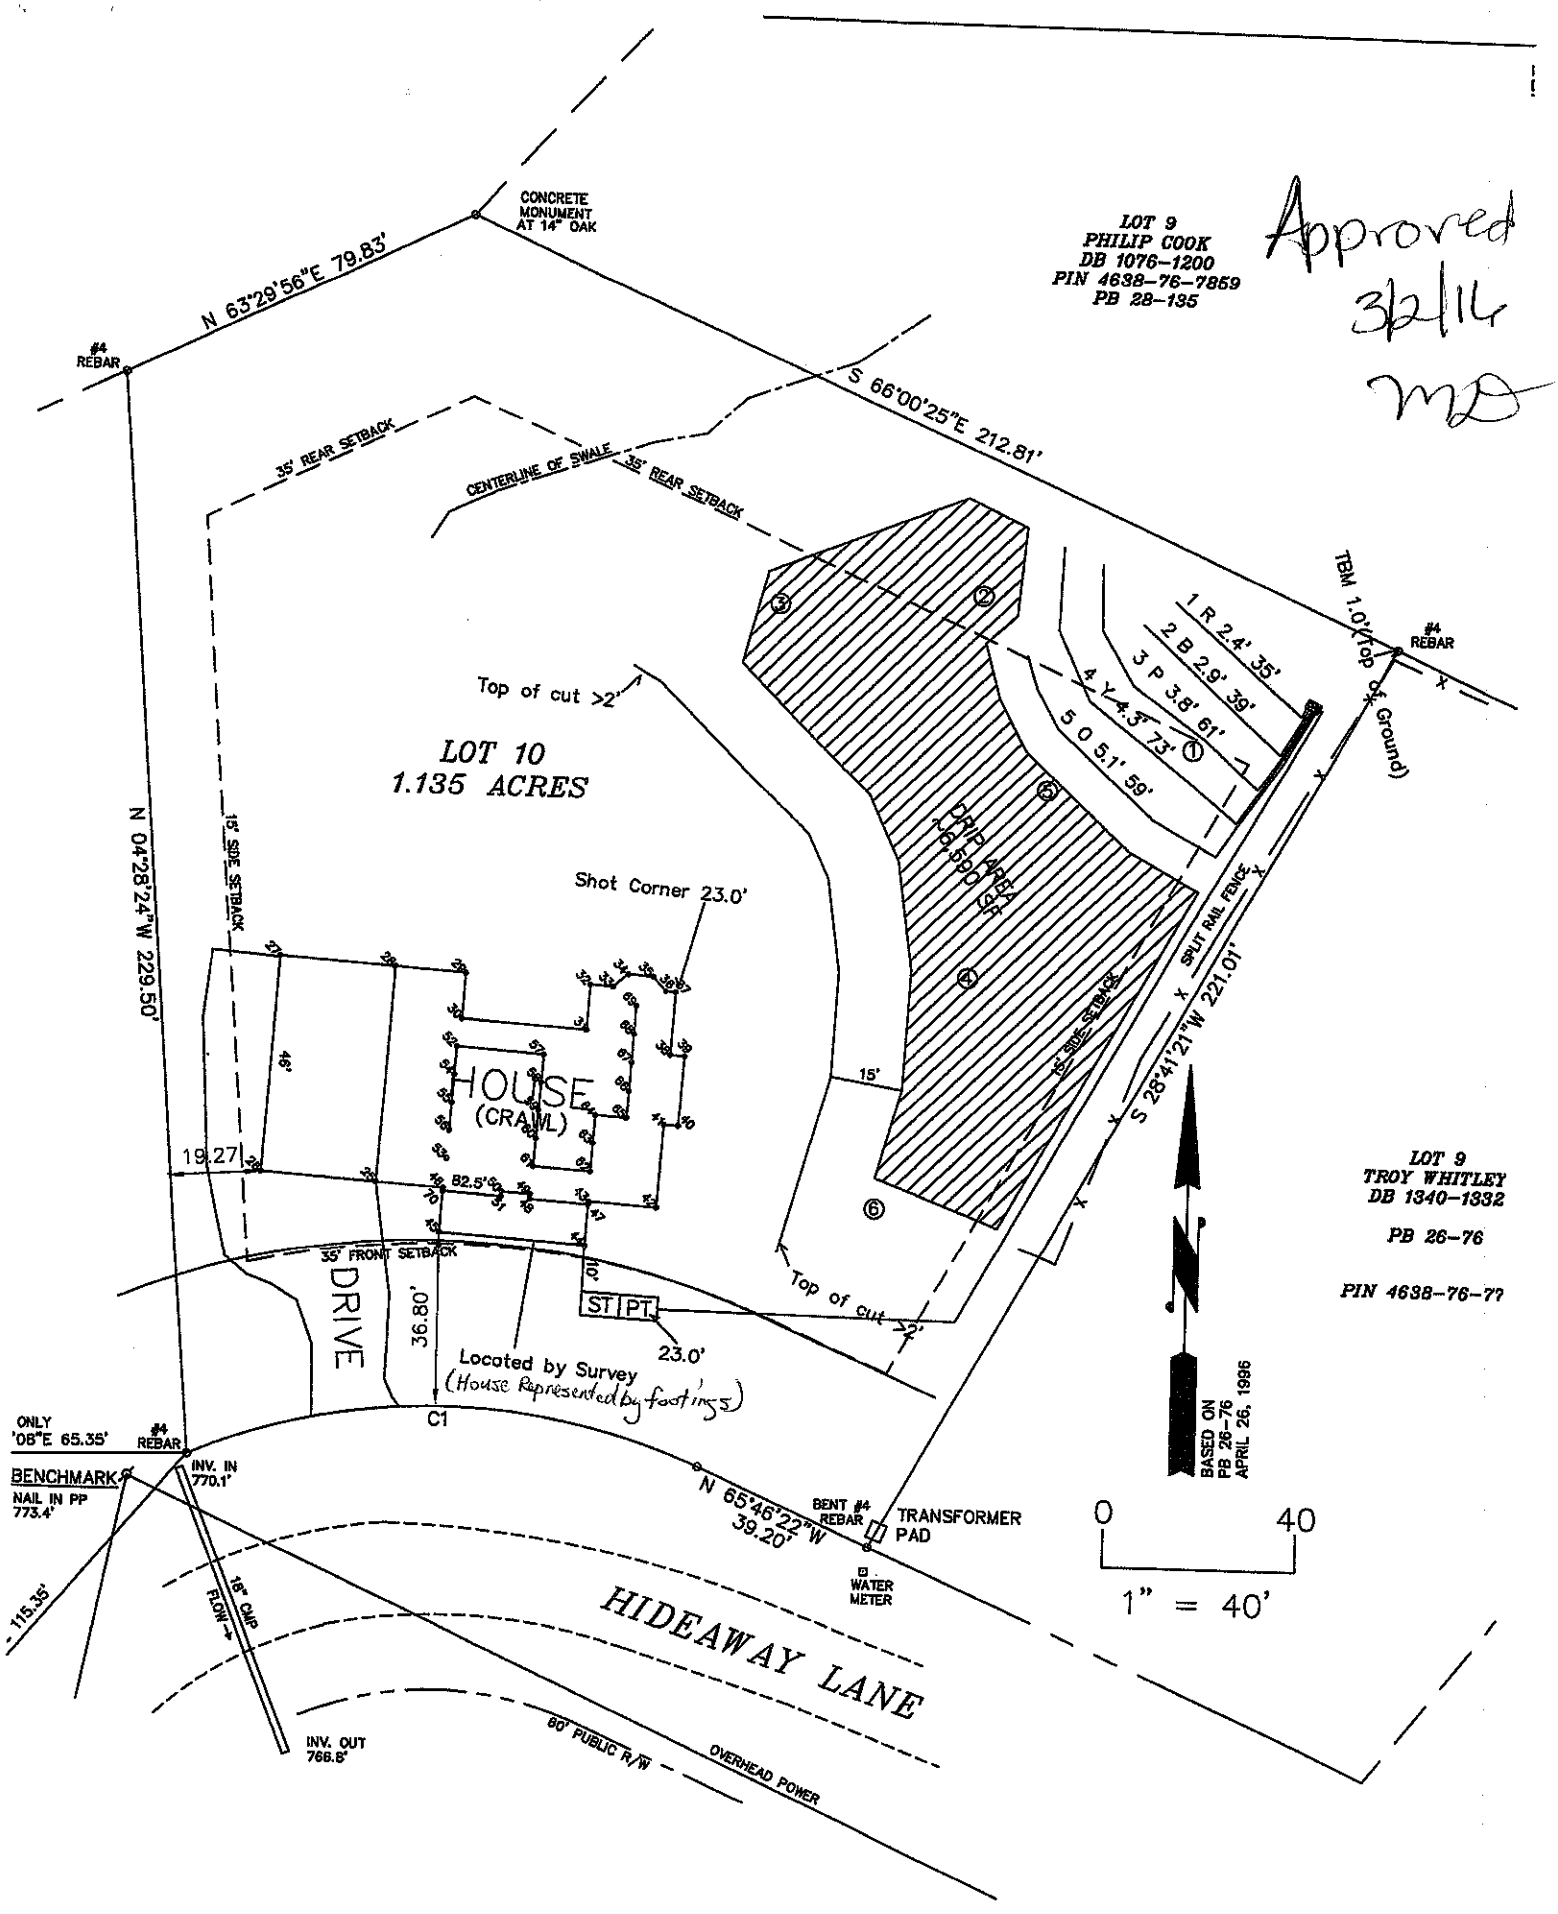
☐ **IMPROVEMENT PERMIT** *with plat valid without expiration.* ☒ **IMPROVEMENT PERMIT** *with site plan valid for 60 mos.* ☒ **AUTHORIZATION TO CONSTRUCT** *valid for period equal to IMPROVEMENT PERMIT--not to exceed 60 mo.*

Owner / Applicant Signature: Wendel Overby Date: 3/15/16 Installed by: C. Wayne Orbison

IMPROVEMENT PERMIT by: Maria Dotson RS Date: 3/2/16 OPERATION PERMIT by: BA Date: 8-4-16

AUTHORIZATION TO CONSTRUCT by: Maria Dotson RS Date: 3/2/16 Existing System Inspected by: Date:

Health Dept. Copy - WHITE Applicant (Final Approval) - YELLOW Applicant (Conditional Approval) - PINK


LOT 9
PHILIP COOK
DB 1076-1200
PIN 4638-76-7859
PB 28-135
Approved
3/2/16
MD
CONCRETE MONUMENT AT 14" OAK
N 63°29'56"E 79.83'
#4 REBAR
S 66°00'25"E 212.81'
35' REAR SETBACK
CENTERLINE OF SWALE
35' REAR SETBACK
TBM 1.0'(Top of Ground)
#4 REBAR
1 R 2.4' 35'
2 B 2.9' 39'
3 P 3.8' 61'
4 Y 4.3' 73'
5 O 5.1' 59'
Top of cut >2'
LOT 10
1.135 ACRES
N 04°28'24"W 229.50'
15' SIDE SETBACK
Shot Corner 23.0'
15' SIDE SETBACK
S 28°41'21"W 221.01'
SPLIT RAIL FENCE
HOUSE
(CRAWL)
46'
19.27'
82.5'
15'
35' FRONT SETBACK
DRIVE
36.80'
10'
ST PT
23.0'
Top of cut >2'
Located by Survey
(House Represented by footings)
C1
LOT 9
TROY WHITLEY
DB 1340-1332
PB 26-76
PIN 4638-76-77
BASED ON PB 26-76 APRIL 26, 1996
ONLY '08"E 65.35'
#4 REBAR
BENCHMARK
NAIL IN PP
773.4'
INV. IN
770.1'
N 65°46'22"W
39.20'
BENT #4 REBAR
TRANSFORMER PAD
WATER METER
115.35'
18" CMP FLOW
INV. OUT
766.8'
HIDEAWAY LANE
60' PUBLIC R/W
OVERHEAD POWER
0
40
1" = 40'