IREDELL COUNTY HEALTH DEPARTMENT

Const. Auth. STATESVILLE 704-878-5305 MOORESVILLE 704-664-5281

IMPROVEMENT PERMIT / ~~CERTIFICATE OF COMPLETION~~ / OPERATION PERMIT / EXISTING SYSTEM INSPECTION

PROPERTY DESCRIPTION NO. 066831 DATE July 31, '97 TAX MAP NO. ~~4638 77 1146~~ 4638-76-7859 Watershed: ☑ Yes ☐ No

OWNER OR CONTRACTOR Stumpy Creek LLC PHONE: Business _____ Home _____

ADDRESS 614 N. Main St Salisbury 28144

LOCATION Peeler Rd. N. TL Whitnell Ct. at end 30010

SUBDIVISION Harborview BLOCK / SECTION 4 LOT 4 LOT AREA 1.16 ac SITE CLASS. PS DESIGN FLOW ~~440gpd~~ 360 L.T.A.R. .3

Septic Tank: 1000 Gallons; STB 825 Date 10/2/97

Pump Tank: _____ Gallons; PT _____ Date _____

Pump Make: _____ Model _____ Serial No. _____

Nitrification Field: No Fields 1 Square Feet 1200 Linear Feet 400

No Lines 5@80' Trench Width 36" Max Trench Bottom Depth ~30" Gravel Depth NA

☑ New System ☐ Repair System Type: I II III IV V VI Conv.

System Description: gravity Chambered

Repair System Description: Same

Maintenance Agreement Required: ☐ Yes ☑ No

☑ House/Mod. Home No. Bedrooms 3

☐ Mobile Home No. Bathrooms 2.5

☐ Business No. Employees _____

☐ Other _____

☑ Slab ☐ Crawl Space ☐ Basement w/plumbing ☐ Basement wo/plumbing

Water Supply:
☐ Individual
☑ Community
☐ Public


Comments: * ONE INSpection port per Lateral

Comments: Changed to Conventional due to 3BR


* OUTBUILDING APPROVED FOR SITE 4/27/98

INITIAL SITE SKETCH

1" = 50'

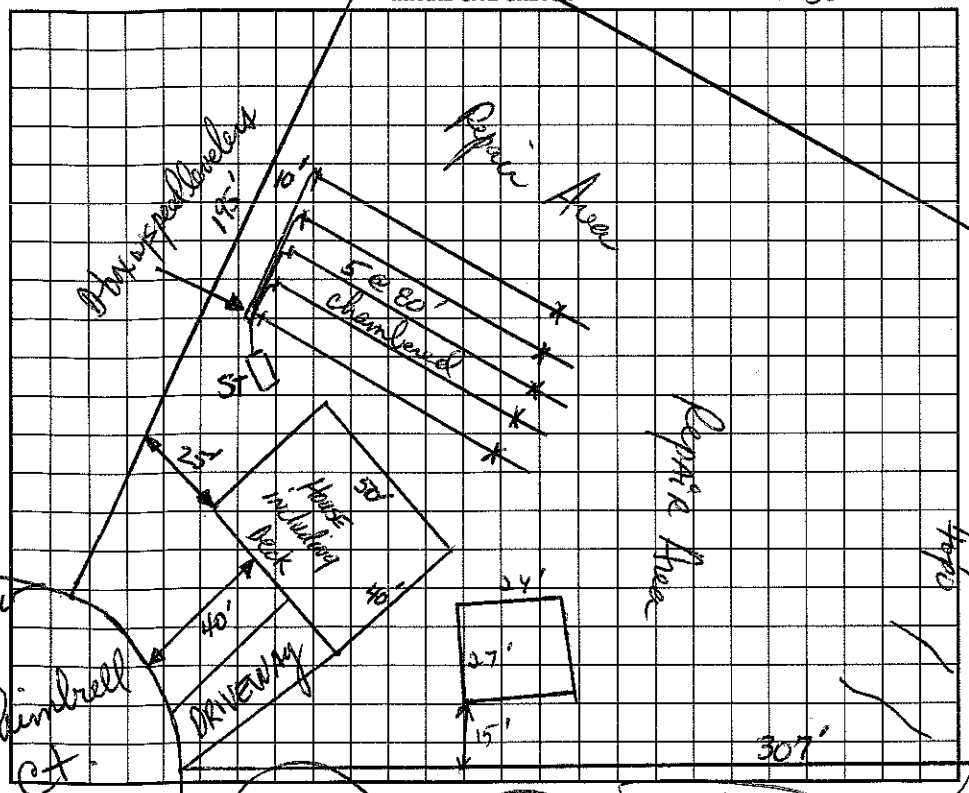

AS BUILT SKETCH

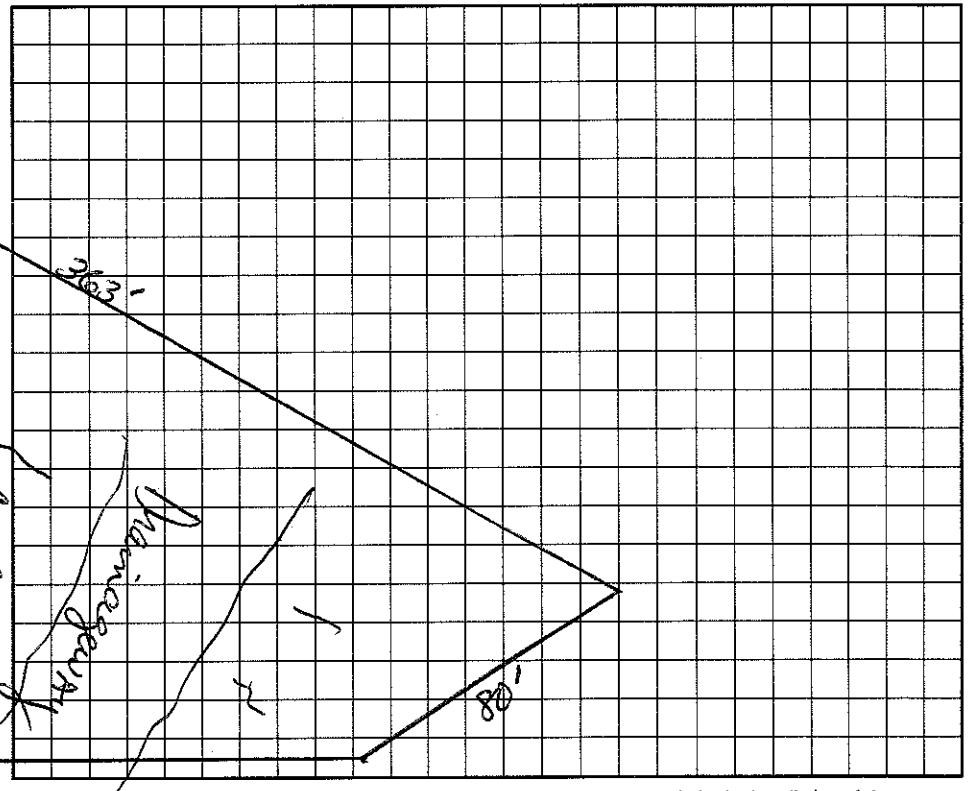

I understand that this permit can be suspended or revoked if any ~~false information~~ is supplied toward securing the permit/any unauthorized changes are made to the site/any unauthorized changes are made in the installation of the system. Improvement Permit is valid for 60 months from date of issuance.

Signed: _____

Improvement Permit by: DR Thomas, RS date 7-31-97

~~Existing System Inspection~~ CONSTRUCTION AUTHORIZATION by: _____ date 8/13/97

Installed by: ROWAN SEPTIC

Certificate of Completion by: _____ date _____

Operation Permit by: _____ date 1/11/98

HEALTH DEPT. COPY: WHITE INSPECTION COPY (FINAL): GREEN OWNER COPY (FINAL): YELLOW INSPECTION COPY (INITIAL): PINK OWNER COPY (INITIAL): GOLD