IREDELL COUNTY HEALTH DEPARTMENT

→ AUTHORIZATION TO CONSTRUCT

STATESVILLE 704-878-5305 MOORESVILLE 704-664-5281

IMPROVEMENT PERMIT / ~~CERTIFICATE OF COMPLETION~~ / OPERATION PERMIT / EXISTING SYSTEM INSPECTION

PROPERTY DESCRIPTION NO. 23229 DATE 8/12/96 TAX MAP NO. pt of 25A80 Watershed: ☐ Yes ☐ No

OWNER OR CONTRACTOR STUMPY CREEK LLC PHONE: Business 633-6124 ~~Home~~ 4638-76-8643

ADDRESS 614 N MAIN ST SALISBURY NC 28144

LOCATION 150 W - TR PEETH RD - TL HIDEAWAY LN 8TH LOT ON RT

SUBDIVISION HARBORVIEW BLOCK / SECTION 1 LOT 8 LOT AREA .71 AC SITE CLASS PS DESIGN FLOW ~~480GPD~~ L.T.A.R. .3G PD/FT²

Septic Tank: 1000 Gallons; STB 825 Date 2/5/97

Pump Tank: _____ Gallons; PT _____ Date _____

Pump Make: _____ Model _____ Serial No. _____

Nitrification Field: No. Fields 1 Square Feet 1200 Linear Feet ~~400~~ 300

No. Lines ~~5~~ 4 Trench Width 36" Max Trench Bottom Depth ≈ 24" Gravel Depth N/A

☑ New System ☐ Repair System Type: I, II, III, IV, V, VI

System Description: GRAVITY CHAMBERED

Repair System Description: PUMP CHAMBERED

Maintenance Agreement Required: ☐ Yes ☑ No

☑ House/Mod. Home No. Bedrooms ~~3~~ 3

☐ Mobile Home No. Bathrooms 1.5

☐ Business No. Employees _____

☐ Other _____


☑ Slab ☐ Crawl Space ☐ Basement w/plumbing ☐ Basement wo/plumbing

Water Supply: ☐ Individual ☑ Community ☐ Public

Comments:

Comments:

INITIAL SITE SKETCH

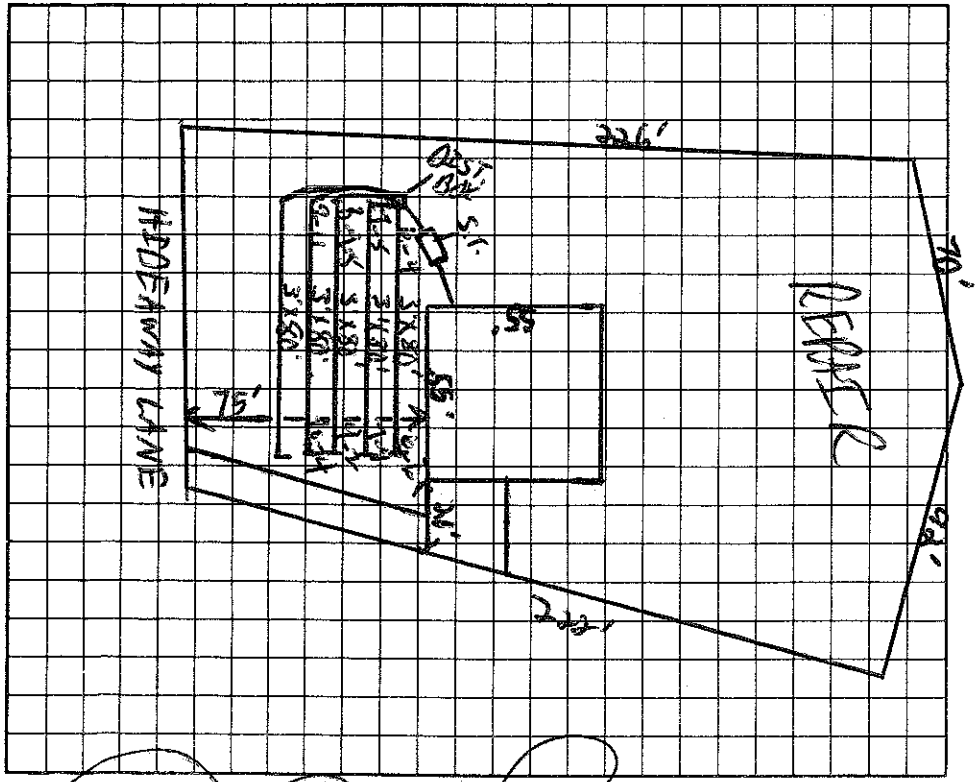

AS BUILT SKETCH

I understand that this permit can be suspended or revoked if any false information is supplied toward securing the permit/any unauthorized changes are made to the site/any unauthorized changes are made in the installation of the system.

Signed: _____

Installed by: Rowan Septic Tank

Improvement Permit by: C. Bly Thomas EHSP date 8/12/96

~~Existing System Inspection by:~~ AUTHORIZATION TO CONSTRUCT C. Bly Thomas EHSP date 8/12/96

Certificate of Completion by: Wesley Sparks RS date 4/15/97

Operation Permit by: Wesley Sparks RS date 4/15/97

HEALTH DEPT. COPY: WHITE INSPECTION COPY (FINAL): GREEN OWNER COPY (FINAL): YELLOW INSPECTION COPY (INITIAL): PINK OWNER COPY (INITIAL): GOLD