IREDELL COUNTY HEALTH DEPARTMENT

AUTHORIZATION TO CONSTRUCT

STATESVILLE 704-878-5305 MOORESVILLE 704-664-5281

(4) (330)

IMPROVEMENT PERMIT / ~~CERTIFICATE OF COMPLETION~~ / OPERATION PERMIT / EXISTING SYSTEM INSPECTION

PROPERTY DESCRIPTION NO. ~~5322~~ 23228 DATE 8/10/96 TAX MAP NO. PT OF 2548 0 Watershed: ☑ Yes ☐ No

OWNER OR CONTRACTOR STUMPY CREEK LLC PHONE: Business 633-6124 ~~Home~~ 4638-96-9534

ADDRESS 614 N MAIN ST SALISBURY NC 28144

LOCATION 150 W - TR DERITH RD - TL HEDGAWAY LN - 7TH LOT ON RT

SUBDIVISION HARBORVIEW BLOCK / SECTION 1 LOT 7 LOT AREA .66 AC SITE CLASS PS DESIGN FLOW 360 GPD ~~400 GPD~~ L.T.A.R. .3GPD/FT

Septic Tank: 1000 Gallons; STB 825 Date 1-11-97

Pump Tank: _____ Gallons; PT _____ Date _____

Pump Make: _____ Model _____ Serial No. _____

Nitrification Field: No Fields 1 Square Feet 1200 Linear Feet 400

No Lines 5 Trench Width 36" Max Trench Bottom Depth ~24" Gravel Depth N/A

☑ New System ☐ Repair System Type: I, II, (III), IV, V, VI

System Description: GRAVITY CHAMBERED

Repair System Description: PUMP CHAMBERED

Maintenance Agreement Required: ☐ Yes ☑ No

☑ House/Mod. Home No. Bedrooms ~~4~~ 3

☐ Mobile Home No. Bathrooms 2.5

☐ Business No. Employees _____

☐ Other _____


☑ Slab ☐ Crawl Space ☐ Basement w/plumbing ☐ Basement wo/plumbing

Water Supply: ☐ Individual ☑ Community ☐ Public

Comments:

Comments: APPROVED FOR 400' OF CONVENTIONAL SYSTEM. CHANGED TO 3BR.

INITIAL SITE SKETCH 1"=60'

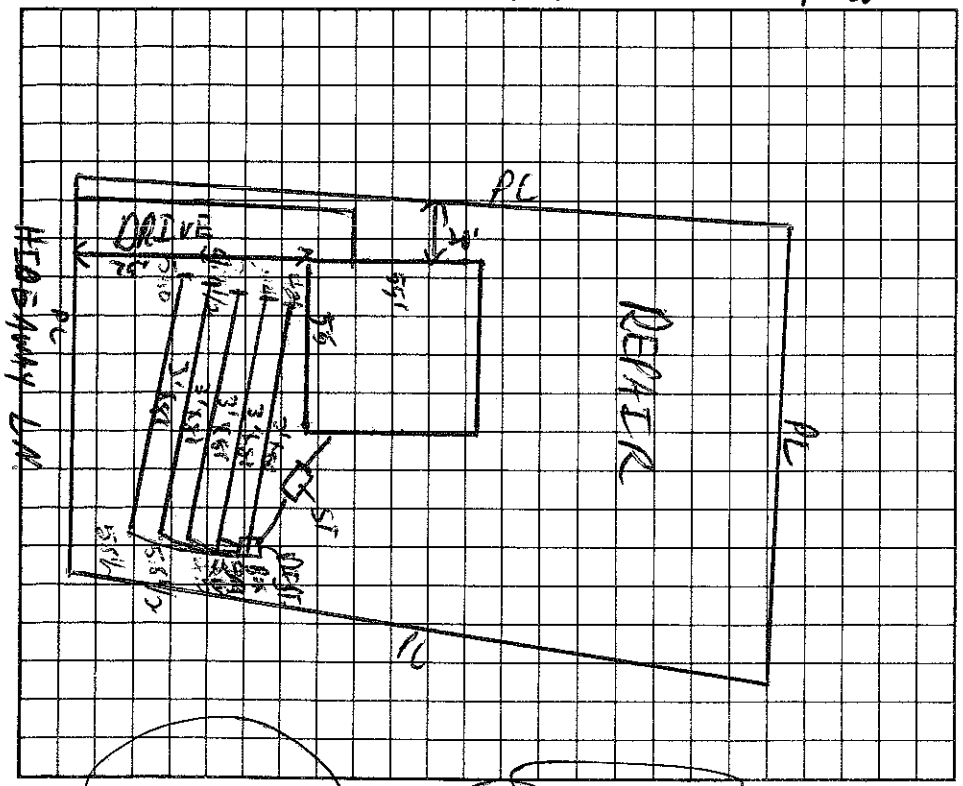

AS BUILT SKETCH

Same as sketch but Conventional.

I understand that this permit can be suspended or revoked if any false information is supplied toward securing the permit/any unauthorized changes are made to the site/any unauthorized changes are made in the installation of the system.

Signed: _____

Installed by: _____

Improvement Permit by: C. Beth Teem, EHSI date 8/10/96

Certificate of Completion by: _____ date _____

Authorization to Construct Existing System Inspection by: C. Beth Teem EHSI date 8/12/96

Operation Permit by: Maria Dotson for C. Beth Teem date 4/3/97

HEALTH DEPT. COPY: WHITE INSPECTION COPY (FINAL): GREEN OWNER COPY (FINAL): YELLOW INSPECTION COPY (INITIAL): PINK OWNER COPY (INITIAL): GOLD