-(3:30)-

IREDELL COUNTY HEALTH DEPARTMENT

STATESVILLE 704-878-5305 MOORESVILLE 704-664-5281

IMPROVEMENT PERMIT / CERTIFICATE OF COMPLETION / OPERATION PERMIT / EXISTING SYSTEM INSPECTION

PROPERTY DESCRIPTION NO. 25358 DATE 2/24/97 TAX MAP NO. 25-4-51 pt of Watershed: ☐ Yes ☐ No

OWNER OR CONTRACTOR STUMPY CREEK LLC PHONE: Business 633-6124 ~~Home~~ 4638-77-0598

ADDRESS 614 N MAIN ST SALISBURY NC 28144

LOCATION DEATH RD. TL SEATRAIL. ON LEFT.

SUBDIVISION HARBRVIEW BLOCK / SECTION 6 LOT 8 LOT AREA 1.60 AC SITE CLASS. PS DESIGN FLOW 480GPD L.T.A.R. .30 TO/FT

Septic Tank: 1000 Gallons; STB 825 Date 9/15/97

Pump Tank: _____ Gallons; PT _____ Date _____

Pump Make: _____ Model _____ Serial No. _____

Nitrification Field: No Fields 1 Square Feet 1260 Linear Feet 420

No Lines 7@60' Trench Width 36" Max Trench Bottom Depth 36" ~~Gravel Depth~~ SAND

☑ New System ☐ Repair System Type: I, II, (III), IV, V, VI

System Description: GRAVITY CHAMBERED

Repair System Description: GRAVITY PANEL

Maintenance Agreement Required: ☐ Yes ☑ No

☑ House/Mod. Home ☐ Mobile Home ☐ Business ☐ Other

No. Bedrooms 4 No. Bathrooms 4 No. Employees _____


☐ Slab ☑ Crawl Space ☐ Basement w/plumbing ☐ Basement wo/plumbing

Water Supply: ☐ Individual ☑ Community ☐ Public


Comments: SEE HEALTH DEPARTMENT BEFORE INSTILLATION. ***

Comments: IP ONLY - DO NOT ISSUE BUILDING PERMIT.

INITIAL SITE SKETCH 1" = 100'

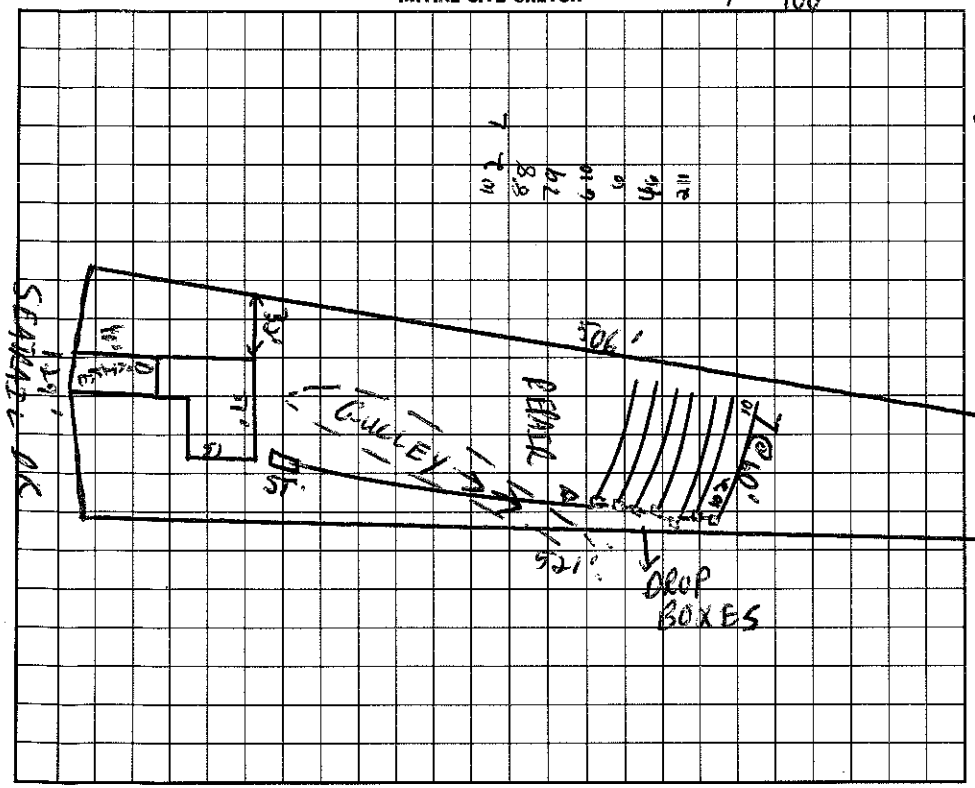

AS BUILT SKETCH

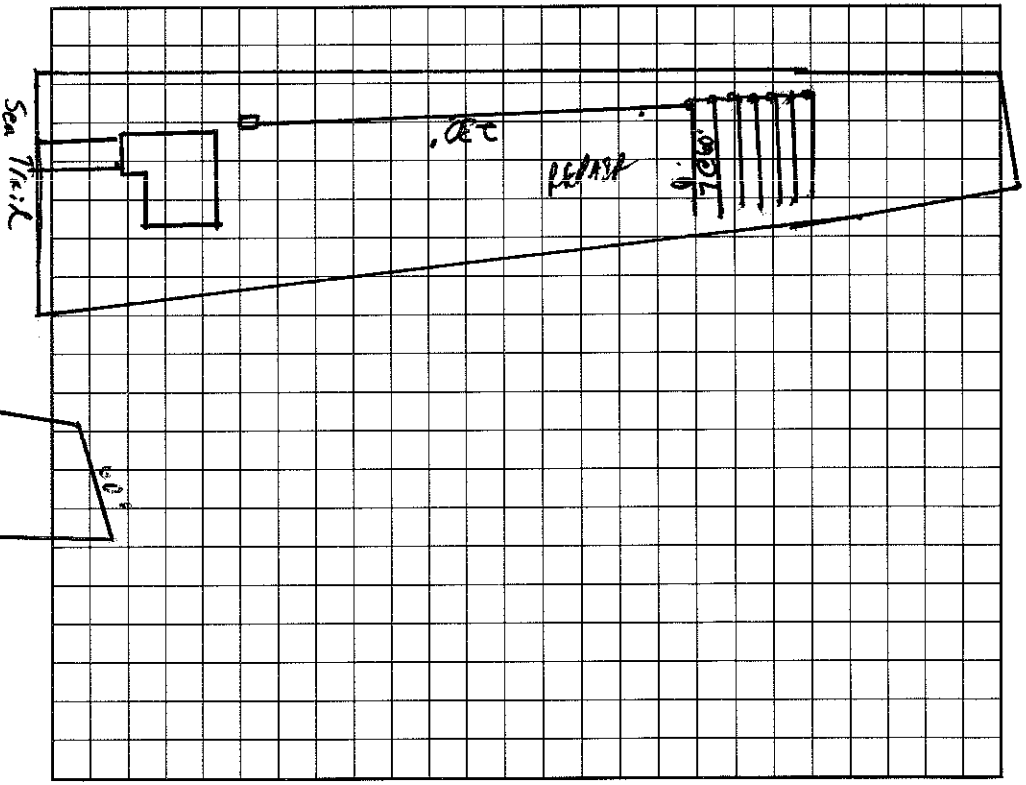

I understand that this permit can be suspended or revoked if any false information is supplied toward securing the permit/any unauthorized changes are made to the site/any unauthorized changes are made in the installation of the system. Improvement Permit is valid for 60 months from date of issuance.

Signed: _____ Installed by: ROWAN SEPTIC

Improvement Permit by: C. [signature] EAST date 2/24/97 Certificate of Completion by: _____ date _____

Construction/Existing System Inspection by: [signature] RS date 6/27/97 Operation Permit by: [signature] date 12/19/97

Auth Rep

HEALTH DEPT. COPY: WHITE INSPECTION COPY (FINAL): GREEN OWNER COPY (FINAL): YELLOW INSPECTION COPY (INITIAL): PINK OWNER COPY (INITIAL): GOLD