IREDELL COUNTY HEALTH DEPARTMENT

↑ AUTHORIZATION TO CONSTRUCT

STATESVILLE 704-878-5305 MOORESVILLE 704-6

IMPROVEMENT PERMIT / ~~CERTIFICATE OF COMPLETION~~ / OPERATION PERMIT / EXISTING SYSTEM

PROPERTY DESCRIPTION NO. 25357 DATE 5/27/97 TAX MAP NO. 25-A-51 Pt of Waters

OWNER OR CONTRACTOR CARLO McKoy PHONE: Business 4638-77-2509 Home 597-1461

ADDRESS 4516 NEW GARDEN Ct CHARLOTTE NC 28215

LOCATION PERTH RD - TL SEATRAIL - LOT ON LEFT

SUBDIVISION HARBORVIEW BLOCK / SECTION 6 LOT 7 LOT AREA 1.11AC SITE CLASS. PS DESIGN FLOW 360GPD L.T.A.R. .36GPD/FT²

Septic Tank: 1000 Gallons; STB 1012 Date 7/28/97

Pump Tank: _____ Gallons; PT _____ Date _____

Pump Make: _____ Model _____ Serial No. _____

Nitrification Field: No Fields 1 Square Feet 1200 Linear Feet 400

No Lines 5@80 Trench Width 36" Max Trench Bottom Depth 36" Gravel Depth 12"

☑ New System ☐ Repair System Type: I, II, III, IV, V, VI

System Description: GRAVITY CONVENTIONAL

Repair System Description: CHAMBERED OR SIMILAR

Maintenance Agreement Required: ☐ Yes ☑ No

☑ House/Mod. Home No. Bedrooms 3

☐ Mobile Home No. Bathrooms 2

☐ Business No. Employees ____

☐ Other _____


☐ Slab ☑ Crawl Space ☐ Basement w/plumbing ☐ Basement wo/plumbing

Water Supply: ☐ Individual ☑ Community ☐ Public

Comments: Tanks & lines checked - (1st visit)

Comments:

INITIAL SITE SKETCH 1" = 160'

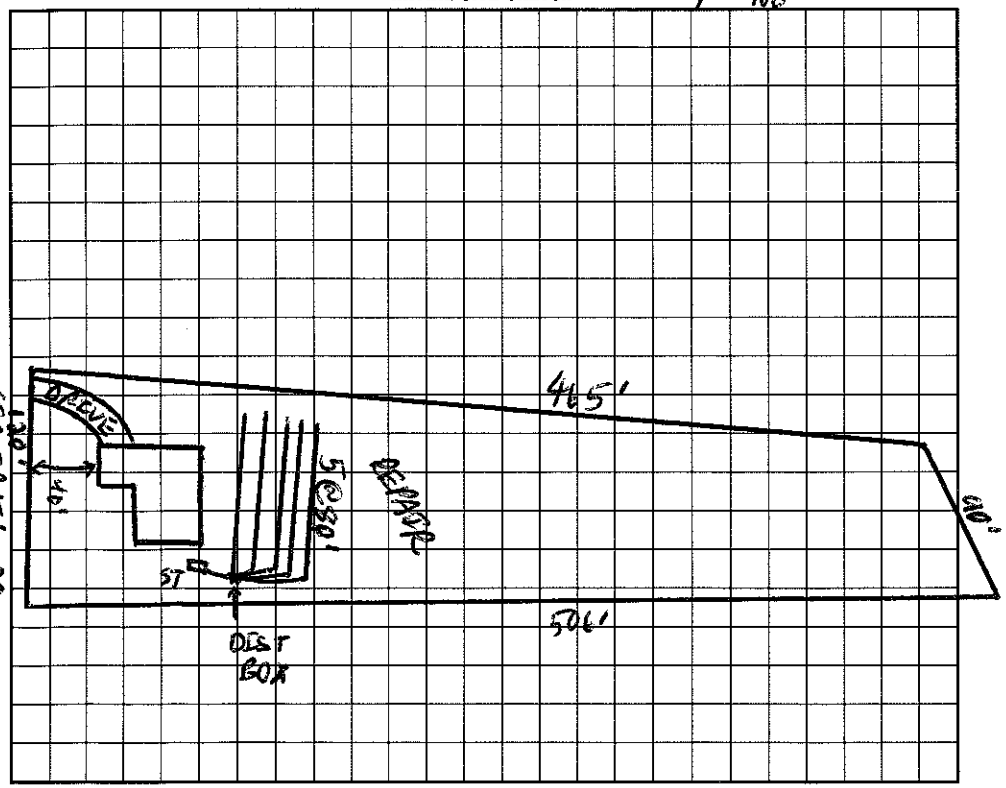

AS BUILT SKETCH

Installed as Drawn

I understand that this permit can be suspended or revoked if any false information is supplied toward securing the permit/any unauthorized changes are made to the site/any unauthorized changes are made in the installation of the system. Improvement Permit is valid for 60 months from date of issuance.

Signed: Carlo McKoy 7-10-97

Improvement Permit by: _____ date 5/27/97

Existing System Inspection by: _____ date 5/27/97

Installed by: Donald Lackey Tank Serv.

Certificate of Completion by: Maria H Watson date 10/14/97

Operation Permit by: Maria H Watson date 10/14/97

AUTHORIZATION TO CONSTRUCT

HEALTH DEPT. COPY: WHITE INSPECTION COPY (FINAL): GREEN OWNER COPY (FINAL): YELLOW INSPECTION COPY (INITIAL): PINK OWNER COPY (INITIAL): GOLD