COUNTY HEALTH DEPARTMENT

AUTHORIZATION TO CONSTRUCT (3:00)

STATESVILLE 704-878-5305 MOORESVILLE 704-664-5281

IMPROVEMENT PERMIT / ~~CERTIFICATE OF COMPLETION~~ / OPERATION PERMIT / EXISTING SYSTEM INSPECTION

PROPERTY DESCRIPTION NO. 25355 DATE 2/24/97 TAX MAP NO. 25-4-51 pt of Watershed: ☒ ~~Yes~~ ☐ No

OWNER OR CONTRACTOR STUMPY CREEK LLC PHONE: Business 633-6124 ~~Home~~ 4638-77-4614

ADDRESS ~~PERTH RD - TL SEA TRAIL DR - ON L~~ 614 N MAIN SALISBURY NC 28144

LOCATION ~~DERTH RD - TL SEA TRAIL - ON LT~~ 360

SUBDIVISION HARBOR VIEW BLOCK / SECTION 6 LOT 5 LOT AREA 1.03 AC SITE CLASS. 05 DESIGN FLOW ~~360~~ L.T.A.R. .3

Septic Tank: 1000 Gallons; STB 1012 Date 6/25/97

Pump Tank: ____ Gallons; PT ____ Date ____

Pump Make: ____ Model ____ Serial No. ____

Nitrification Field: No Fields 1 Square Feet 1200 Linear Feet 400

No Lines 5@50 Trench Width 36" Max Trench Bottom Depth 36" Gravel Depth SAND

☒ New System ☐ Repair System Type: I, II, III, IV, V, VI

System Description: GRAVITY ~~CHAMBERED~~

Repair System Description: PANEL CONVENTIONAL

Maintenance Agreement Required: ☐ Yes ☒ No

☒ House/Mod. Home ☐ Mobile Home ☐ Business ☐ Other

No. Bedrooms 3/4 No. Bathrooms 4 No. Employees ____


☐ Slab ☒ Crawl Space ☐ Basement w/plumbing ☐ Basement wo/plumbing

Water Supply: ☐ Individual ☒ ~~Community~~ ☐ Public


Comments:

Comments: ~~[redacted]~~ - OK FOR BUILDING PERMIT - CBP

INITIAL SITE SKETCH

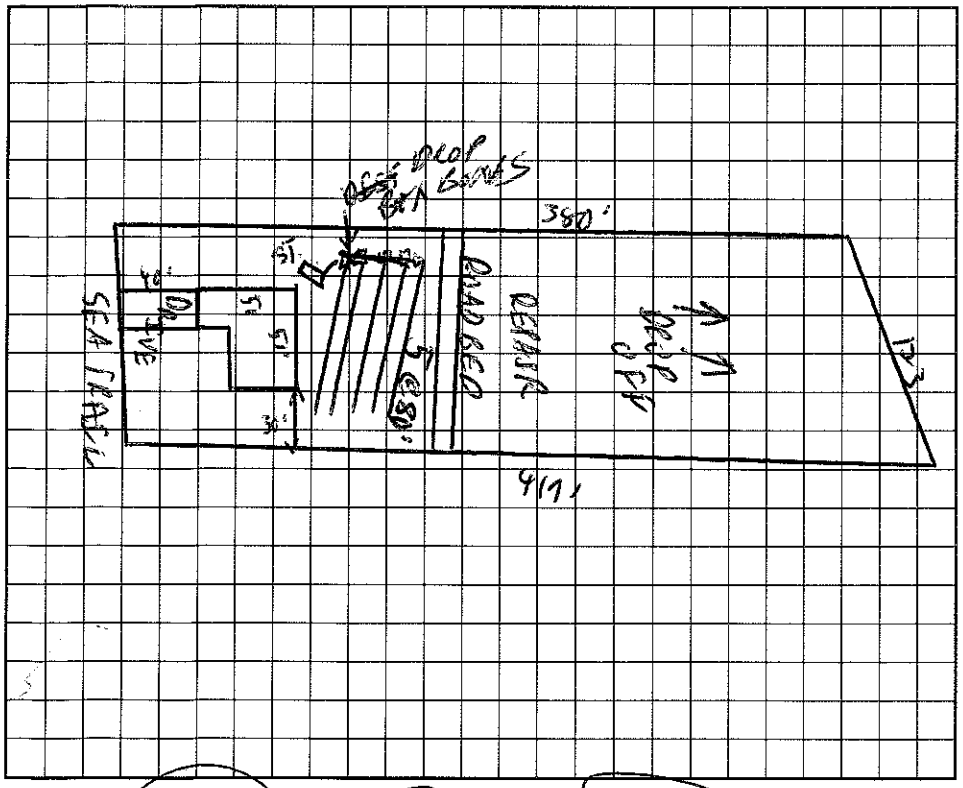

AS BUILT SKETCH

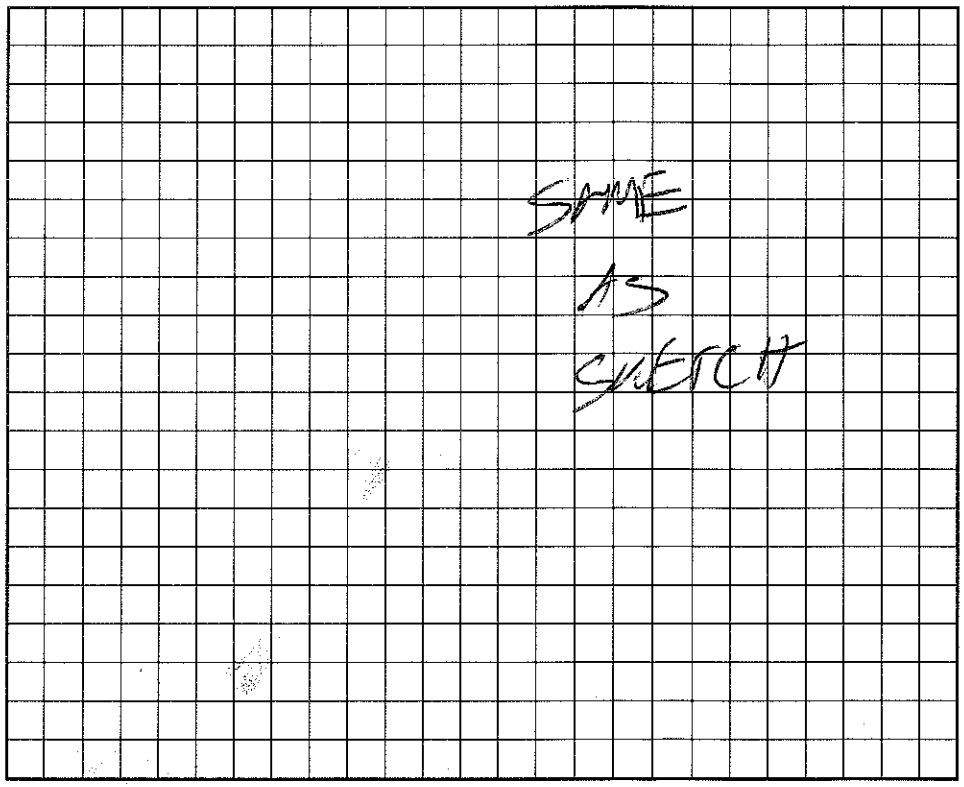

I understand that this permit can be suspended or revoked if any false information is supplied toward securing the permit/any unauthorized changes are made to the site/any unauthorized changes are made in the installation of the system. Improvement Permit is valid for 60 months from date of issuance.

Signed: ____ Installed by: DONALD LACKEY

Improvement Permit by: C. [signature] FOR date 2/24/97 Certificate of Completion by: ____ date ____

~~Existing System Inspection by~~ AUTHORIZATION TO CONSTRUCT C. [signature] date 4/25/97 Operation Permit by: C. [signature] date 9/3/97

HEALTH DEPT. COPY: WHITE INSPECTION COPY (FINAL): GREEN OWNER COPY (FINAL): YELLOW INSPECTION COPY (INITIAL): PINK OWNER COPY (INITIAL): GOLD