IREDELL COUNTY HEALTH DEPARTMENT

STATESVILLE 704-878-5305 MOORESVILLE 704-664-5281

IMPROVEMENT PERMIT / ~~CERTIFICATE OF COMPLETION~~ / OPERATION PERMIT / EXISTING SYSTEM INSPECTION

Authorization to Construct. (4100) DONALD LACKEY

PROPERTY DESCRIPTION NO. 25378 DATE 2/24/97

OWNER OR CONTRACTOR STUMPY CREEK LLC (Mike Hooper-Builder) TAX MAP NO. 25-A-51

ADDRESS 614 N MAIN ST SALISBURY NC 28144 PHONE: Business 633-4824 ~~Home~~ 4638-77-5917 Watershed: ☐ Yes ☐ No

LOCATION PERTH RD - TL SEA TRAIL DR - CORNER ON AVOCET CT & SEATRAIL DR RT

SUBDIVISION HARBORVIEW BLOCK / SECTION 7 LOT 28 LOT AREA .56 AC SITE CLASS. PS DESIGN FLOW 450GPD L.T.A.R. .36 GPD/FT²

Septic Tank: 1000 Gallons; STB _____ Date 2/17/97

Pump Tank: _____ Gallons; PT _____ Date _____

Pump Make: _____ Model _____ Serial No. _____

Nitrification Field: No Fields 1 Square Feet 1650 Linear Feet 550

No Lines 5@110' Trench Width 36" Max Trench Bottom Depth 36" Gravel Depth 12"

☑ New System ☐ Repair System Type: I, II, III, IV, V, VI

System Description: GRAVITY CONVENTIONAL

Repair System Description: CHAMBERS OR SIMILAR

Maintenance Agreement Required: ☐ Yes ☑ No

☑ House/Mod. Home No. Bedrooms 4

☐ Mobile Home No. Bathrooms 4

☐ Business No. Employees ____

☐ Other _____

☐ Slab ☑ Crawl Space ☐ Basement w/plumbing ☐ Basement wo/plumbing


Water Supply: ☐ Individual ☑ Community ☐ Public

Comments:

Comments: IP ONLY - DO NOT ISSUE BUILDING PERMIT

installed as shown

INITIAL SITE SKETCH 1" = 60'

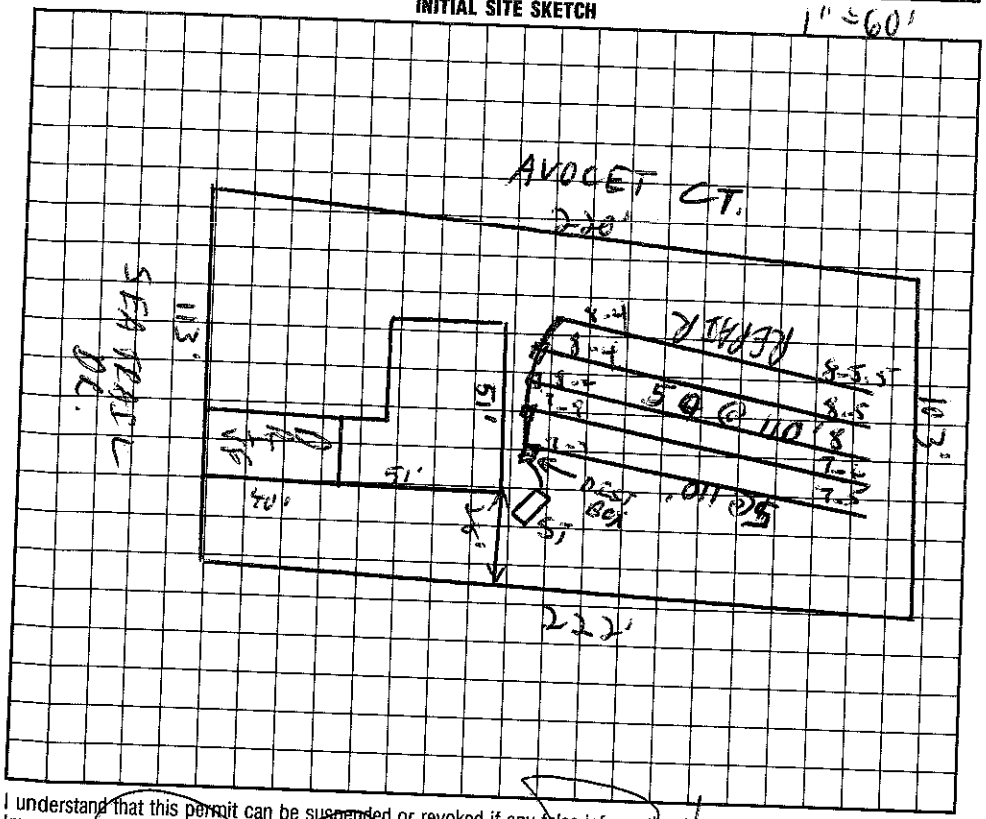

AS BUILT SKETCH

I understand that this permit can be suspended or revoked if any false information is supplied toward securing the permit/any unauthorized changes are made to the site/any unauthorized changes are made in the installation of the system. Improvement Permit is valid for 60 months from date of issuance.

Signed: _____

Improvement Permit by: _____ date 2/24/97

~~Existing System Inspection by:~~ & Construct Wesley Sparks R.S. date 3/5/97

Installed by: Donald Lackey

Certificate of Completion by: Wesley Sparks R.S. date 4/18/97

Operation Permit by: Wesley Sparks R.S. date 4/18/97

HEALTH DEPT. COPY: WHITE INSPECTION COPY (FINAL): GREEN OWNER COPY (FINAL): YELLOW INSPECTION COPY (INITIAL): PINK OWNER COPY (INITIAL): GOLD