4638 77 6775

IREDELL COUNTY HEALTH DEPARTMENT

STATESVILLE 704-878-5305 MOORESVILLE 704-664-5281

IMPROVEMENT PERMIT / CERTIFICATE OF COMPLETION / OPERATION PERMIT / EXISTING SYSTEM INSPECTION

PROPERTY DESCRIPTION NO. 25353 DATE 2/24/97 TAX MAP NO. 25-A-51 pt of 1 Watershed: ☐ Yes ☐ No

OWNER OR CONTRACTOR STUMPY CREEK LLC PHONE: Business 633-6124 Home

ADDRESS 614 N MAIN ST SALISBURY

LOCATION PERTH RD - TL SEABAIL - ON LEFT

SUBDIVISION HARBORVIEW BLOCK / SECTION 6 LOT 3 LOT AREA .951C SITE CLASS. PS DESIGN FLOW 360 GPD L.T.A.R. .36 GPD/FT²

Septic Tank: 1000 Gallons; STB 794 Date 3/23/99

Pump Tank: 1000 Gallons; PT 27 Date 9/12/99

Pump Make: MYERS Model ME 505-11 Serial No. 7/99

Nitrification Field: No Fields 1 Square Feet ~~600~~ 400 Linear Feet 200

No Lines 4@50' Trench Width 24" Max Trench Bottom Depth 36" Gravel Depth N/A

☑ New System ☐ Repair System Type: I, II, (III), IV, V, VI

System Description: PUMP PANEL - Press. Manifold

Repair System Description: PUMP PANEL

Maintenance Agreement Required: ☐ Yes ☑ No

☑ House/Mod. Home No. Bedrooms 3

☐ Mobile Home No. Bathrooms 3

☐ Business No. Employees

☐ Other

☐ Slab ☑ Crawl Space ☐ Basement w/plumbing ☐ Basement wo/plumbing


Water Supply:
☐ Individual
☑ Community
☐ Public

Comments:

Comments: ~~EP ONLY DO NOT ISSUE~~ ~~BUILDING~~ ~~PERMIT~~

1" = 60'

INITIAL SITE SKETCH

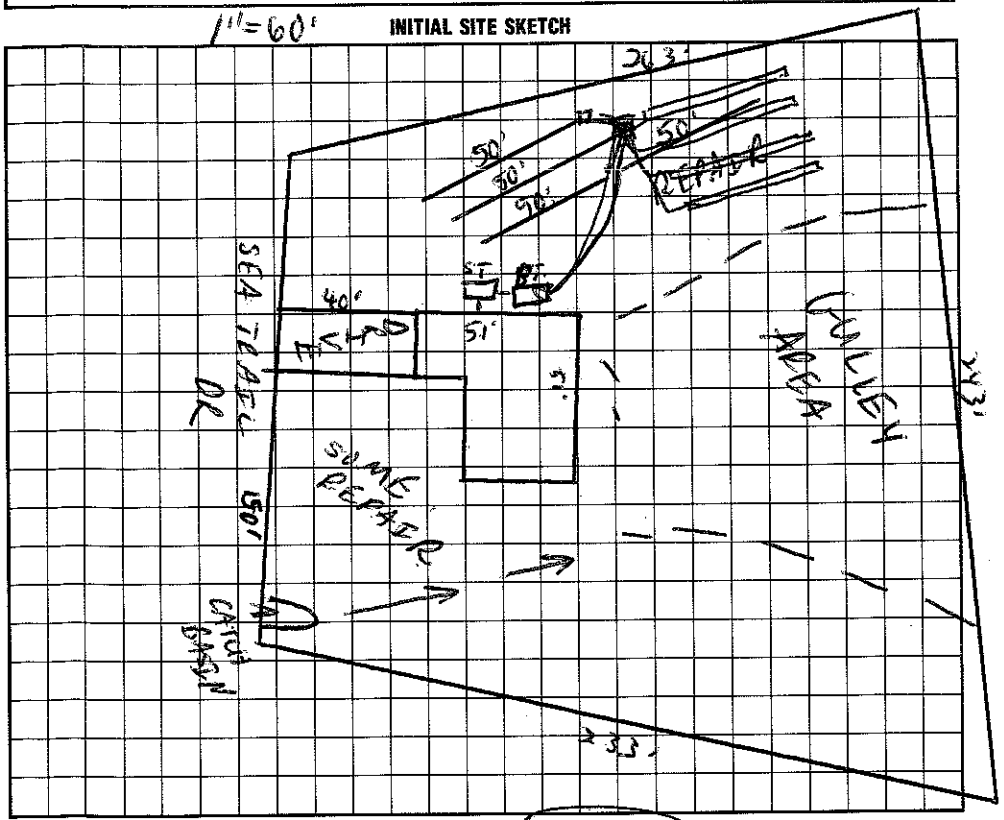

AS BUILT SKETCH

I understand that this permit can be suspended or revoked if any false information is supplied toward securing the permit/any unauthorized changes are made to the site/any unauthorized changes are made in the installation of the system. Improvement Permit is valid for 60 months from date of issuance.

Signed:

Improvement Permit by: C [illegible] Zoom EHSI date 2/24/97

Existing System Inspection by: Jeff Morgan date 3/16/99

Installed by: Wayne Onlison

Certificate of Completion by: Wesley Sparks REHS date 10/99

Operation Permit by: date

HEALTH DEPT. COPY: WHITE INSPECTION COPY (FINAL): GREEN OWNER COPY (FINAL): YELLOW INSPECTION COPY (INITIAL): PINK OWNER COPY (INITIAL): GOLD