IREDELL COUNTY HEALTH DEPARTMENT

STATESVILLE 704-878-5305 MOORESVILLE 704-664-5281

IMPROVEMENT PERMIT / AUTHORIZATION TO CONSTRUCT / OPERATION PERMIT / EXISTING SYSTEM INSPECTION

PERMIT # REPAIR PIN # 4638-77-8371 DATE 5-3-11

OWNER or APPLICANT RODNEY KERLEY PHONE: Business 704-502-1679 Home:

OWNER or APPLICANT ADDRESS 123 WOODSTORK COVE

LOCATION / DIRECTIONS PERTH TO WOODSTORK, 123

SUBDIVISION HARBOR VIEW BLOCK / SECTION 5 LOT # 19 LOT AREA .63AC DESIGN FLOW 360 L.T.A.R. .3

Septic Tank 1000 Gallons: STB 760 Date 10-23-10 ☐ New System ☐ Repair ☐ Expansion System Type I (II) III IV V VI

Pump Tank ____ Gallons: PT ____ Date ____ System Description: 1000 GAL TANK

Pump Make ____ Model ____ Serial # ____ Repair System Description: ____

Nitrification Field No Fields EXISTING No Lines Linear Feet 400' Maintenance Agreement Required ☐ YES ☒ NO

Trench Width ____ Max. Trench Bottom Depth ____ Gravel Depth 12" ☒ GRAVITY ☐ PRESSURE


☒ Residence No. Bedrooms 3 ☐ Business No. Persons ____ ☐ Other No. Employees ____ ☐ Slab ☒ Crawl Space ☐ Basement w/plumbing ☐ Basement w/o plumbing

Water Supply: ☒ Private ☐ Public ☒ Community

Comments / Conditions ① PUMP CRUSH & FILL OLD TANK ② INSTALL NEW TANK AS SHOWN

Comments / Conditions

INITIAL SITE SKETCH

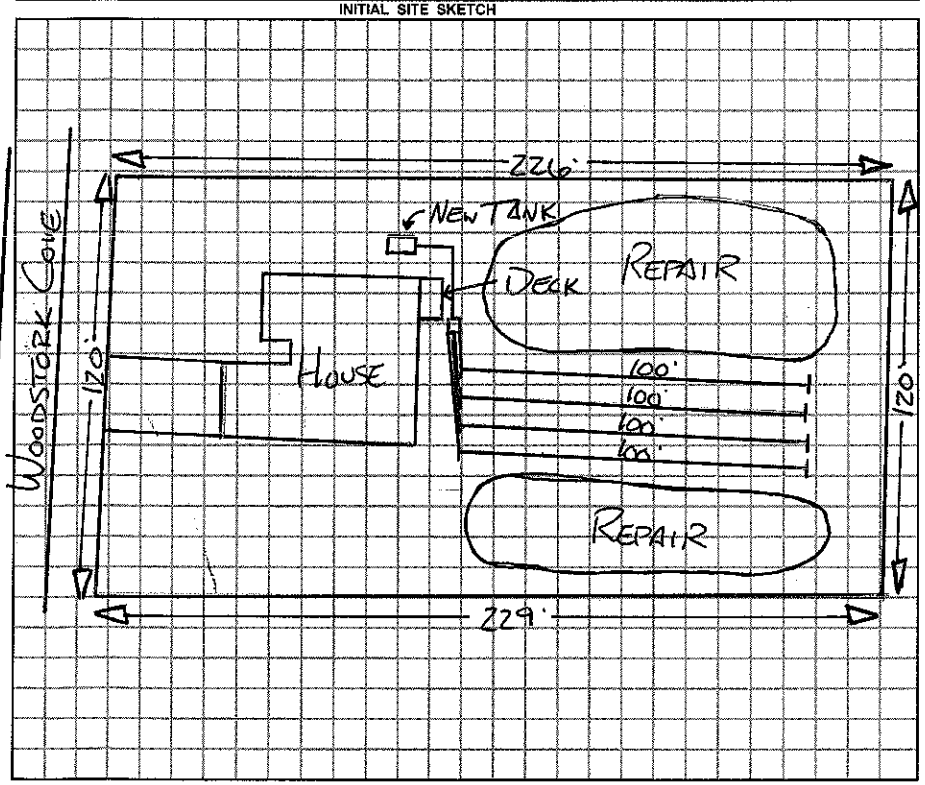

AS BUILT SKETCH

1"=60'

Permit can be suspended or revoked if any false information is supplied toward securing the permit / any unauthorized changes are made to the site / any unauthorized changes are made in the installation of the system.

☐ *IMPROVEMENT PERMIT w / plat valid without expiration.* ☐ *IMPROVEMENT PERMIT w / site plan valid for 60 mos.* ☒ *AUTHORIZATION TO CONSTRUCT valid for period equal to IMPROVEMENT PERMIT-not to exceed 60 mo.*

Owner / Applicant Signature: ____ Date ____

Improvement Permit by: REHS Date 5-4-11

Authorization to Construct by: REHS Date 5-4-11

Installed by: ____

Operation Permit by: REHS Date: 5-9-11

Existing System Inspected by: ____ Date: ____

YOU SHOULD CONTACT A LOCATOR SERVICE PRIOR TO ANY EXCAVATION.

WHITE COPY Environmental Health YELLOW COPY (Final) Owner / Applicant PINK COPY (Initial) Owner / Applicant