3.60

# IREDELL COUNTY HEALTH DEPARTMENT

STATESVILLE 704-878-5305 MOORESVILLE 704-664-5281

## IMPROVEMENT PERMIT / CERTIFICATE OF COMPLETION / OPERATION PERMIT / EXISTING SYSTEM INSPECTION

PROPERTY DESCRIPTION NO. 25352 DATE 1/22/97 TAX MAP NO. 25-A-51 pt Watershed: ☑ Yes ☐ No

OWNER OR CONTRACTOR STUMPY CREEK LLC ~~PHONE: Business~~ 4638-77-8739 Home 633 6124

ADDRESS 614 N MAIN ST SALESBURY NC 28144

LOCATION PEETH RD ~~TR 1 FT PAST STUMPY~~ TL SEATRAIL 2ND LOT ON LEFT 360

SUBDIVISION HARBORVIEW BLOCK / SECTION 6 LOT 2 LOT AREA 1.67 AC SITE CLASS. PS DESIGN FLOW 480GPD L.T.A.R. .36 PD/FT²

Septic Tank: 1000 Gallons; STB 825 Date 8/9/97

Pump Tank: _____ Gallons; PT _____ Date _____

Pump Make: _____ Model _____ Serial No. _____

Nitrification Field: No Fields 1 Square Feet 1200 Linear Feet 400

No Lines 5@80' Trench Width 36" Max Trench Bottom Depth 36" Gravel Depth N/A

☑ New System ☐ Repair System Type: I II III IV V VI

System Description: GRAVITY ~~CHAMBERS~~

Repair System Description: GRAVITY PANEL

Maintenance Agreement Required: ☐ Yes ☑ No

☑ House/Mod. Home No. Bedrooms 3

☐ Mobile Home No. Bathrooms 3

☐ Business No. Employees ____

☐ Other _____

☐ Slab ☑ Crawl Space ☐ Basement w/plumbing ☐ Basement wo/plumbing


Water Supply:
☐ Individual
☑ Community
☐ Public

Comments:


Comments: TP ONLY - DO NOT ISSUE BUILDING PERMIT.

CONVENTIONAL SYSTEM

INITIAL SITE SKETCH 1"=60'

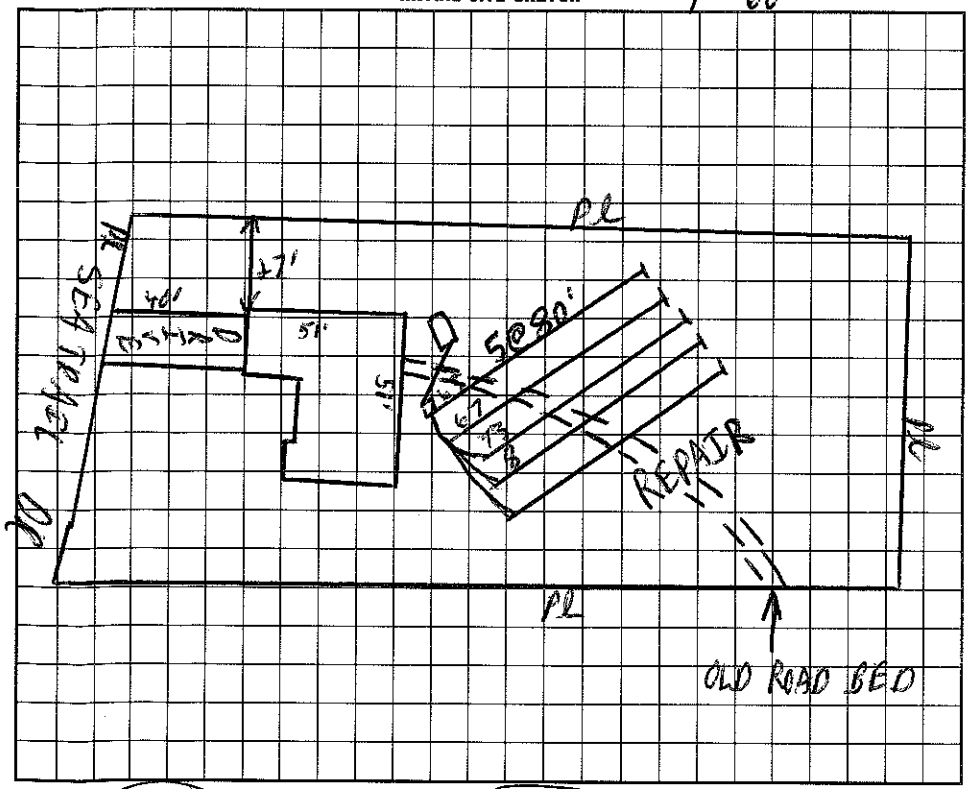


AS BUILT SKETCH

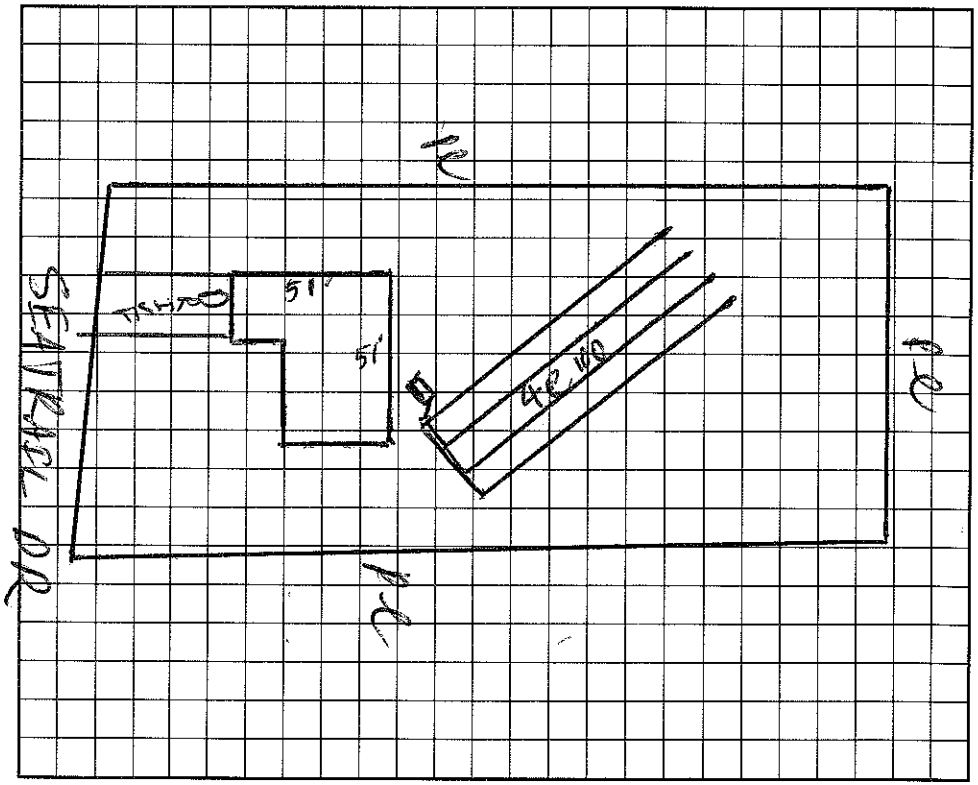


I understand that this permit can be suspended or revoked if any false information is supplied toward securing the permit/any unauthorized changes are made to the site/any unauthorized changes are made in the installation of the system. Improvement Permit is valid for 60 months from date of issuance.

Signed: _____

Improvement Permit by: _____ EHS date 1/22/97

~~Construction~~ ~~Existing System Inspection~~ by: _____ date 6/27/97

Installed by: ROWAN SEPTIC

Certificate of Completion by: _____ date _____

Operation Permit by: _____ date 9/19/97

HEALTH DEPT. COPY: WHITE INSPECTION COPY (FINAL): GREEN OWNER COPY (FINAL): YELLOW INSPECTION COPY (INITIAL): PINK OWNER COPY (INITIAL): GOLD