IREDELL COUNTY HEALTH DEPARTMENT

Const. Auth. STATESVILLE 704-878-5305 MOORESVILLE 704-664-5281

IMPROVEMENT PERMIT / ~~CERTIFICATE OF COMPLETION~~ / OPERATION PERMIT / EXISTING SYSTEM INSPECTION

PROPERTY DESCRIPTION NO. 066833 DATE July 18, '97 TAX MAP NO. 4638 77 1716 4638 77 9150 Watershed: ☑ Yes ☐ No

OWNER OR CONTRACTOR Stumpy Creek LLC PHONE: Business 633-6124 Home W54CA

ADDRESS 614 N. Main Salisbury N.C. 28144

LOCATION Poplar Rd. W. to Whimbrell Ct. on Right at end

SUBDIVISION Harborview BLOCK / SECTION 4 LOT 11 LOT AREA .55Ac SITE CLASS. PS DESIGN FLOW 360gpd L.T.A.R. .3

Septic Tank: 1000 Gallons; STB 825 Date 12-2-97

Pump Tank: ____ Gallons; PT 47 Date 1-10-97

Pump Make: ____ Model ____ Serial No. ____

Nitrification Field: No Fields 1 Square Feet 900 Linear Feet 300

No Lines 4@75' Trench Width 36" Max Trench Bottom Depth ~30" Gravel Depth N/A

☑ New System ☐ Repair System Type: I, II, (III), IV, V, VI

System Description: pumped pressure chambered

Repair System Description: ~~Enviro~~ PANEL

Maintenance Agreement Required: ☐ Yes ☑ No

☑ House/Mod. Home No. Bedrooms 3

☐ Mobile Home No. Bathrooms 2½

☐ Business No. Employees ____

☐ Other ____

☐ Slab ☑ Crawl Space ☐ Basement w/plumbing ☐ Basement wo/plumbing


Water Supply: ☐ Individual ☑ Community ☐ Public

Comments: * ONE inspection port per lateral

Comments:

INITIAL SITE SKETCH

1" = 40'

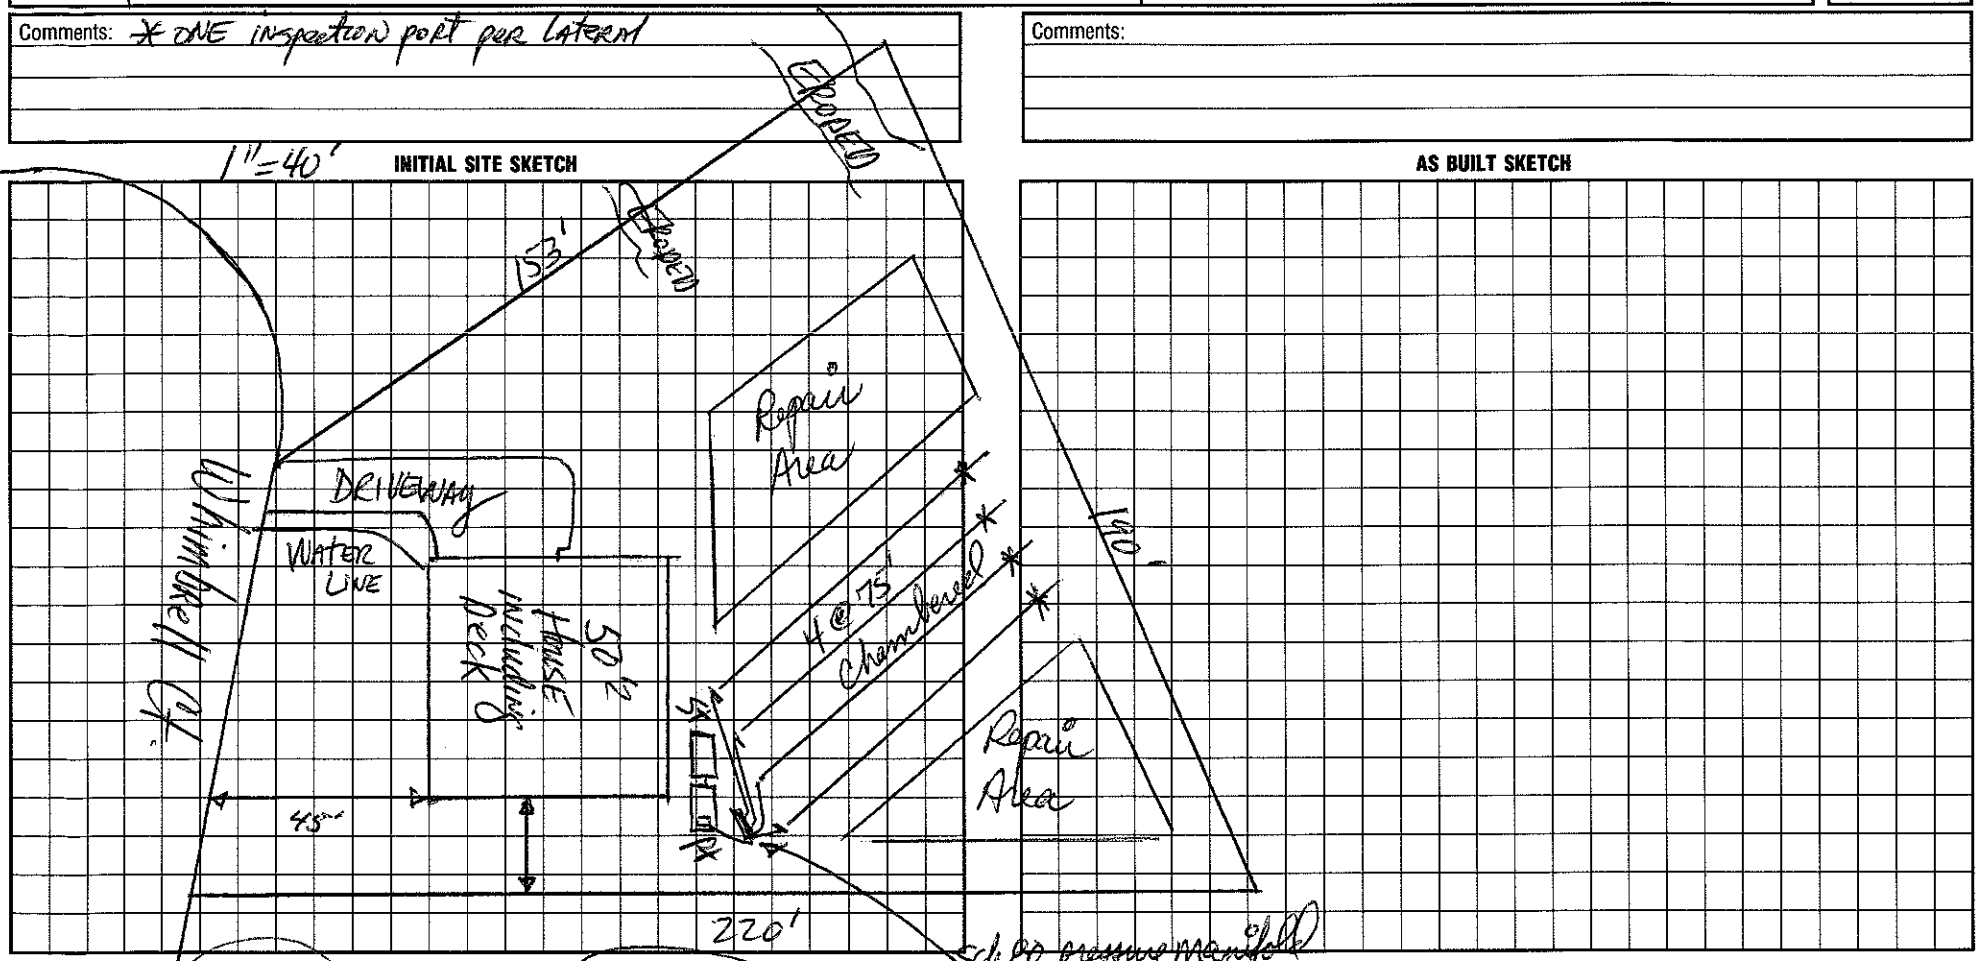

AS BUILT SKETCH

I understand that this permit can be suspended or revoked if any false information is supplied toward securing the permit, any unauthorized changes are made to the site/any unauthorized changes are made in the installation of the system. Improvement Permit is valid for 60 months from date of issuance.

Signed: X

Improvement Permit by: DR Hamm IRS date 7-18-97

~~Existing System Inspection by:~~ Construction Authorization: C Rowan date 8/13/97

Installed by: ROWAN SEPTIC

Certificate of Completion by: ____ date ____

Operation Permit by: C Rowan date 8/18/97

HEALTH DEPT. COPY: WHITE INSPECTION COPY (FINAL): GREEN OWNER COPY (FINAL): YELLOW INSPECTION COPY (INITIAL): PINK OWNER COPY (INITIAL): GOLD