(10:30

IREDELL COUNTY HEALTH DEPARTMENT

STATESVILLE 704-878-5305 MOORESVILLE 704-664-528

IMPROVEMENT PERMIT / AUTHORIZATION TO CONSTRUCT / OPERATION PERMIT / EXISTING SYSTEM

PERMIT# 066840 PIN# ~~4638 77116~~ (pt of) 4638-77-9369 DATE 5/8/98

OWNER OR CONTRACTOR LAKEMONT HOMES PHONE: Business 339-7998 Home

ADDRESS PO BOX 1463 MATTHEWS NC 28105

LOCATION Hwy 150 - TR PERTH - TL WOODSTORK

SUBDIVISION HARBORVIEW BLOCK / SECTION 5 LOT 18 LOT AREA .16AC SITE CLASS. RS DESIGN FLOW 360GPD L.T.A.R. .30 AC/FC

Septic Tank: 1000 Gallons; STB 794 Date 5/8/98
Pump Tank: ____ Gallons; PT ____ Date ____
Pump Make: ____ Model ____ Serial No. ____
Nitrification Field: No Fields 1 Square Feet 1200 Linear Feet 400
No Lines 4@100 Trench Width 36" Max Trench Bottom Depth ~30" Gravel Depth 10

☑ New System ☐ Repair System Type: I, II, III, IV, V, VI
System Description: GRAVITY CONVENTIONAL
Repair System Description: SAME
Maintenance Agreement Required: ☐ Yes ☑ No

☑ House/Mod. Home No. Bedrooms 3
☐ Mobile Home No. Bathrooms 2½
☐ Business No. Employees ____
☐ Other ____


☐ Slab ☑ Crawl Space ☐ Basement w/plumbing ☐ Basement wo/plumbing

Water Supply:
☐ Individual
☐ Public
☐ Community


Comments:/Conditions:

Comments:/Conditions:

INITIAL SITE SKETCH 1"=40'

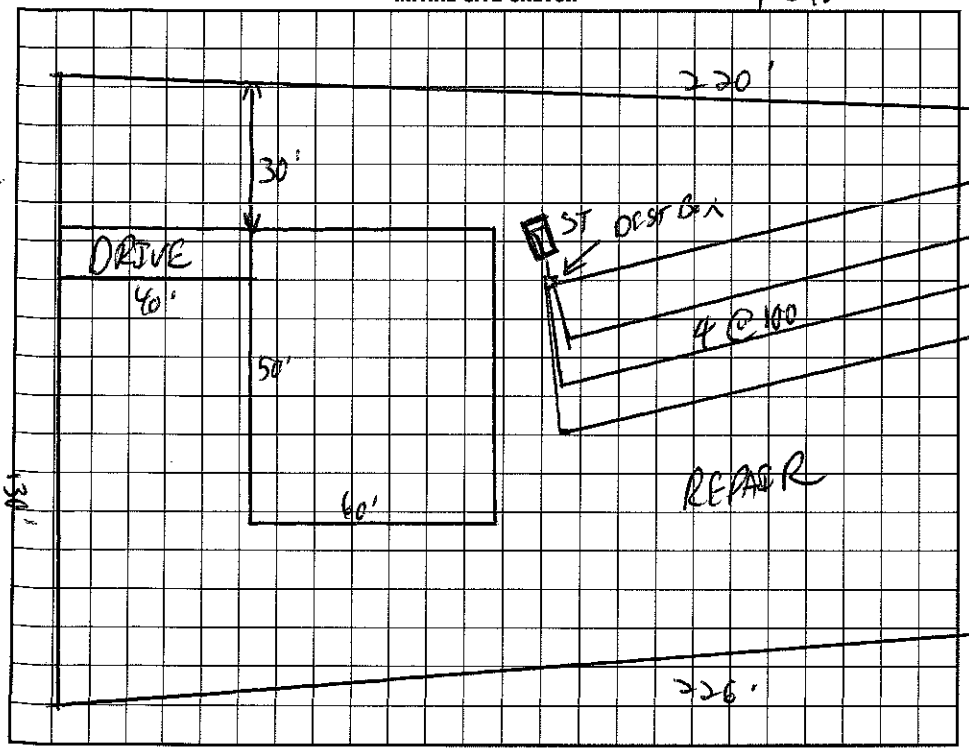

AS BUILT SKETCH

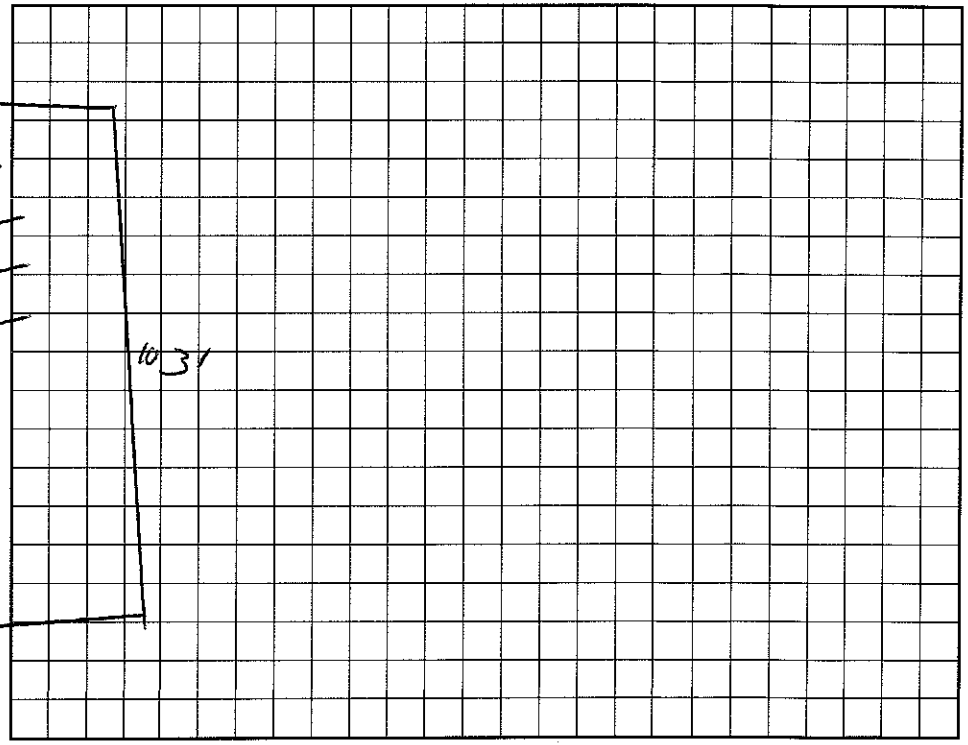

WOODSTORK DR.

I understand that this permit can be suspended or revoked if any false information is supplied toward securing the permit/any unauthorized changes are made to the site/any unauthorized changes are made in the installation of the system. Improvement Permit with plat valid without expiration. Improvement Permit with site plan valid for sixty months. Authorization to Construct is valid for a period equal to that of Improvement Permit – not to exceed sixty months.

Signed: [signature] date ____ Installed by: LARRY BEAM

Improvement Permit by: [signature] RS date 5/8/98 Operation Permit by: [signature] RS date 8/14/98

Authorization to Construct by: [signature] RS date 5/28/98 Existing System Inspection by: ____ date ____

HEALTH DEPT. COPY: WHITE INSPECTION COPY (FINAL): GREEN OWNER COPY (FINAL): YELLOW INSPECTION COPY (INITIAL): PINK OWNER COPY (INITIAL): GOLD