633-78-18

IREDELL COUNTY HEALTH DEPARTMENT

Const. Auth. STATESVILLE 704-878-5305 MOORESVILLE 704-664-5281

IMPROVEMENT PERMIT / ~~CERTIFICATE OF COMPLETION~~ / OPERATION PERMIT / EXISTING SYSTEM INSPECTI

DATE April 2, '96 TAX MAP NO. part of 25A80 4638 78 0971 Watershed: ☑ Yes ☐ No

PROPERTY DESCRIPTION NO. 23213

OWNER OR CONTRACTOR Stumpy Creek LLC PHONE: Business 633-6124 Home

ADDRESS 614 N. Main, Salisbury NC 28144

LOCATION 150' W TR Beth Rd. / TL Stumpy Creek Rd. on left

SUBDIVISION Harborview BLOCK / SECTION II LOT 8 LOT AREA .58Ac SITE CLASS PS pm. 1956 DESIGN FLOW 360gpd. L.T.A.R. .3

Septic Tank: 1000 Gallons; STB 9-25 Date 8/7/96

Pump Tank: 1000 Gallons; PT 47 Date 9/20/96

Pump Make: ZOELLER Model N98B Serial No. 95-000 "L"

Nitrification Field: No. Fields 1 Square Feet 400 Linear Feet 200

No. Lines 4@50 Trench Width 24" Max Trench Bottom Depth ≈ 28" Gravel Depth NA

☑ New System ☐ Repair System Type: I. II (III) IV. V. VI

System Description: pumped-pm- panel block LP chambered

Repair System Description:

Maintenance Agreement Required: ☐ Yes ☑ No initially

☑ Slab ☐ Crawl Space ☐ Basement w/plumbing ☐ Basement wo/plumbing

☑ House/Mod. Home No. Bedrooms 3

☐ Mobile Home No. Bathrooms 2

☐ Business No. Employees

☐ Other

Water Supply: ☐ Individual ☑ Community ☐ Public


Comments: Drainfield area begins 10' off STREET RW where shown.

Comments: 200 Y.C.-96-1/DISE

installed as shown.

1"=60'

INITIAL SITE SKETCH

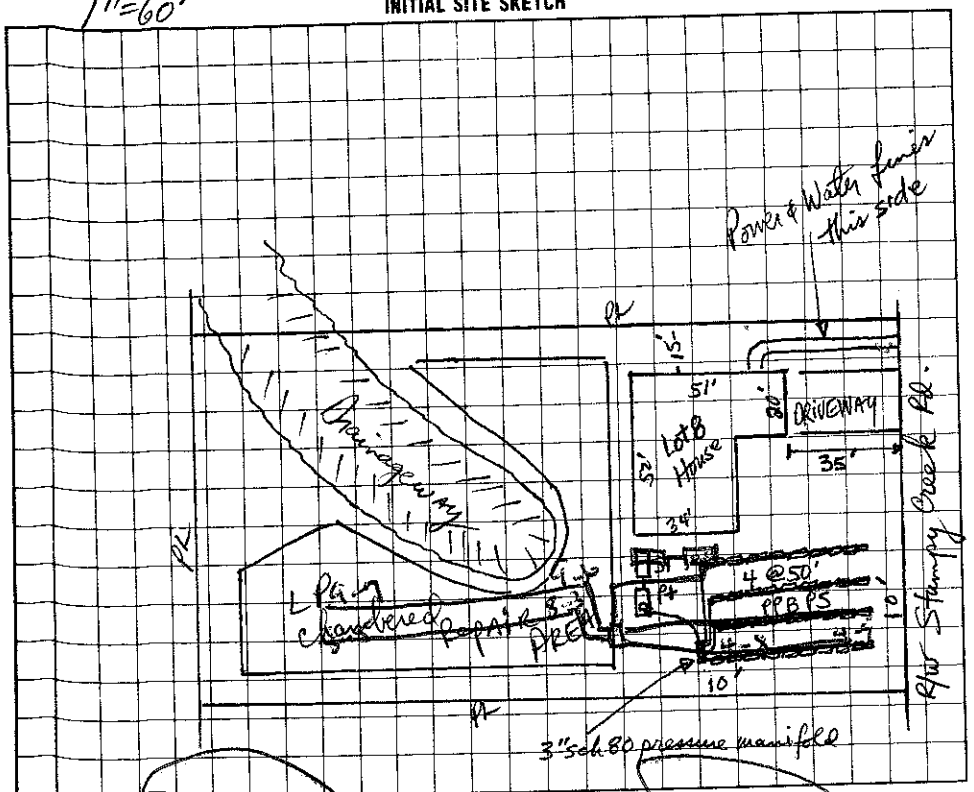

AS BUILT SKETCH

I understand that this permit can be suspended or revoked if any false information is supplied toward securing the permit/any unauthorized changes are made to the site/any unauthorized changes are made in the installation of the system.

Signed: [signature]

Improvement Permit by: [signature] R.S. date 4-2-96

~~Final~~ Construction ~~System~~ Inspection by: D.R. Hunter R.S. date 7-2-96

Installed by: Rowan Septic Tank

Certificate of Completion by: Wesley Sparks R.S. date 1/30/97

Operation Permit by:

INSPECTION COPY (FINAL): GREEN OWNER COPY (FINAL): YELLOW INSPECTION COPY (INITIAL): PINK OWNER COPY (INITIAL): GOLD