# IREDELL COUNTY HEALTH DEPARTMENT

STATESVILLE 704-878-5305 MOORESVILLE 704-664-5281

## IMPROVEMENT PERMIT / AUTHORIZATION TO CONSTRUCT / OPERATION PERMIT / EXISTING SYSTEM INSPECTION

PERMIT# 064563 PIN# ~~4638 77 1716~~ 4638-78-1444 DATE 7/15/98

OWNER OR CONTRACTOR Dem Custom Homes PHONE: Business 597-1461 Home

ADDRESS 4516 New Bedford Ct. Charlotte, NC 28215

LOCATION Tanager Ct. / Perth Rd N. TL Tanager to culde sac, lot straight off culde sac and pert on lot on (L)

SUBDIVISION HARBORVIEW BLOCK / SECTION 8 LOT 6+7 LOT AREA 1.94 Ac SITE CLASS. PS DESIGN FLOW 360 L.T.A.R. .3

Septic Tank: 1000 Gallons; STB 794 Date 8/19/98
Pump Tank: Gallons; PT Date
Pump Make: Model Serial No. 300
Nitrification Field: No Fields 1 Square Feet 1200 Linear Feet ~~400~~
No Lines 4 & 6 Trench Width 36" Max Trench Bottom Depth 30" Gravel Depth 12"

[X] New System [ ] Repair System Type: I (II) III, IV, V, VI
System Description: GRAV Conventional
Repair System Description: GRAV CH PLASTIC
Maintenance Agreement Required: [ ] Yes [X] No


[X] House/Mod. Home No. Bedrooms 3
[ ] Mobile Home No. Bathrooms 3
[ ] Business No. Employees
[ ] Other
[ ] Slab [ ] Crawl Space [X] Basement w/plumbing [ ] Basement wo/plumbing


Water Supply: [ ] Individual [ ] Public [X] Community

Comments:/Conditions: VOIDS PERMIT BY DRH DATED 2/4/98

Comments:/Conditions: 4-1 4-1
8-9 8-9
10-10 10-11
13-4.5 13.5
13-4.5 - AS BUILT SKETCH

INITIAL SITE SKETCH (1" = 100')

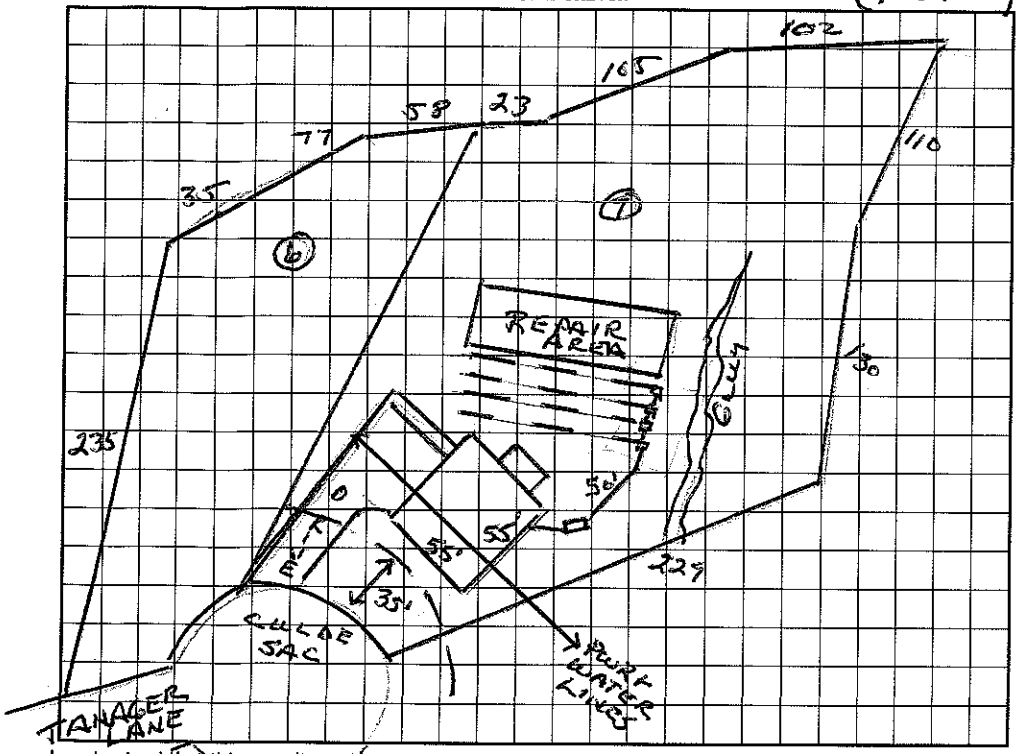

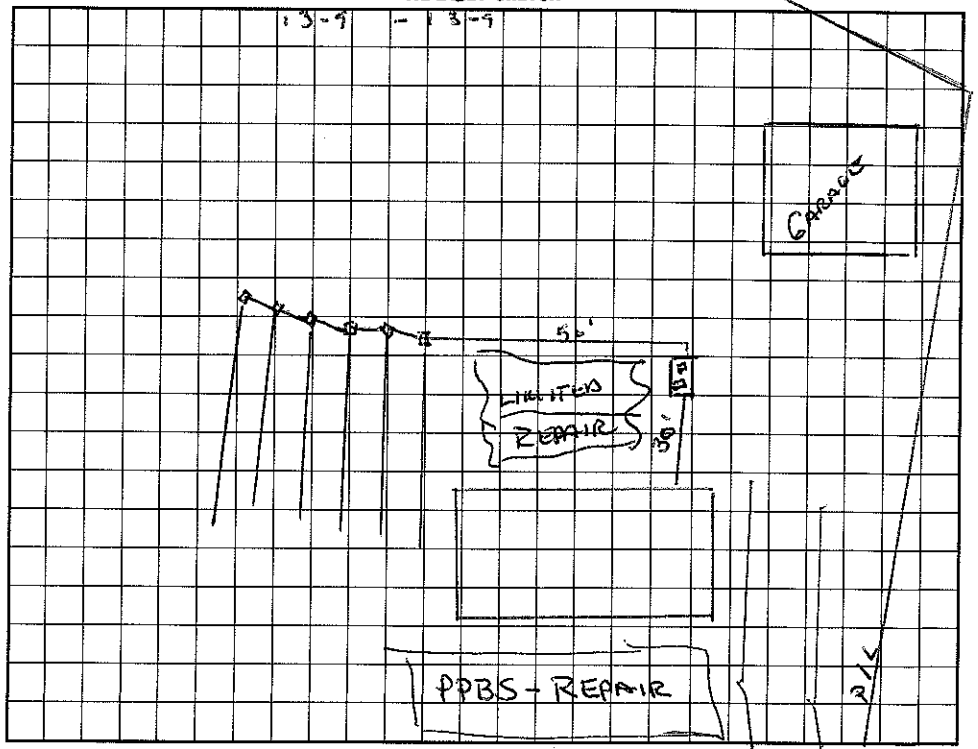
I understand that this permit can be suspended or revoked if any false information is supplied toward securing the permit/any unauthorized changes are made to the site/any unauthorized changes are made in the installation of the system. Improvement Permit with plat valid without expiration. Improvement Permit with site plan valid for sixty months. Authorization to Construct is valid for a period equal to that of Improvement Permit – not to exceed sixty months.

Signed: C. Carl McElroy date 7/6/98

Improvement Permit by: Wesley Sparks R.S. date 7/15/98

Authorization to Construct by: Wesley Sparks RS date 7/15/98

Installed by: Larry Beam

Operation Permit by: Wesley Sparks R.S. date 12/2/98

Existing System Inspection by: date

HEALTH DEPT. COPY: WHITE INSPECTION COPY (FINAL): GREEN OWNER COPY (FINAL): YELLOW INSPECTION COPY (INITIAL): PINK OWNER COPY (INITIAL): GOLD