IREDELL COUNTY HEALTH DEPARTMENT

Statesville Office (704) 878-5305 Mooresville Office (704) 660-3625 PERMIT # 2130 203068

IMPROVEMENT PERMIT / AUTHORIZATION TO CONSTRUCT / OPERATION PERMIT / EXISTING SYSTEM

PIN # 4638-78-1974

APPLICANT: Mike Barricello APPLICANT ADDRESS: 135 Stumpy Creek Rd Mooresville NC

SITE ADDRESS: 135 Stumpy Creek Rd PHONE: 704-660-9878 ALT. PHONE:

SITE DIRECTIONS: Hwy 150W, R on Perth Rd, L on Stumpy Creek Rd, Lot on L


SUBDIVISION: Harborview Pelican Point SECTION: 2 LOT # 7 LOT AREA: DESIGN FLOW: L.T.A.R.:

Septic Tank	1000 (gal)	STB	760	Date	3-24-14	☐ New System ☑ Repair ☐ Expansion	System Type: I (II) III IV V VI	☑ Residence	No. Bedrooms 3
Pump Tank	(gal)	PT		Date		System Description:	EXISTING	☐ Business	No. Persons 6
Pump Make		Model		Serial #		Repair System Description:		☐ Other	No. Employees
# Nitrification Fields	1	# Lines	EXISTING	Linear Ft:		Maintenance Agreement Required:	☐ YES ☑ NO	☐ Slab	☑ Crawl Space
Trench Width		Max. Trench Bottom Depth		Gravel Depth			☑ GRAVITY ☐ PRESSURE	☐ Basement w/plumbing	☐ Basement w/o plumbing

Water Supply: ☐ Private ☑ Public ☑ Community

Comments / Conditions: EXISTING ST TO BE PUMPED, CRUSHED, AND BACKFILLED. filter installed

INITIAL SITE SKETCH

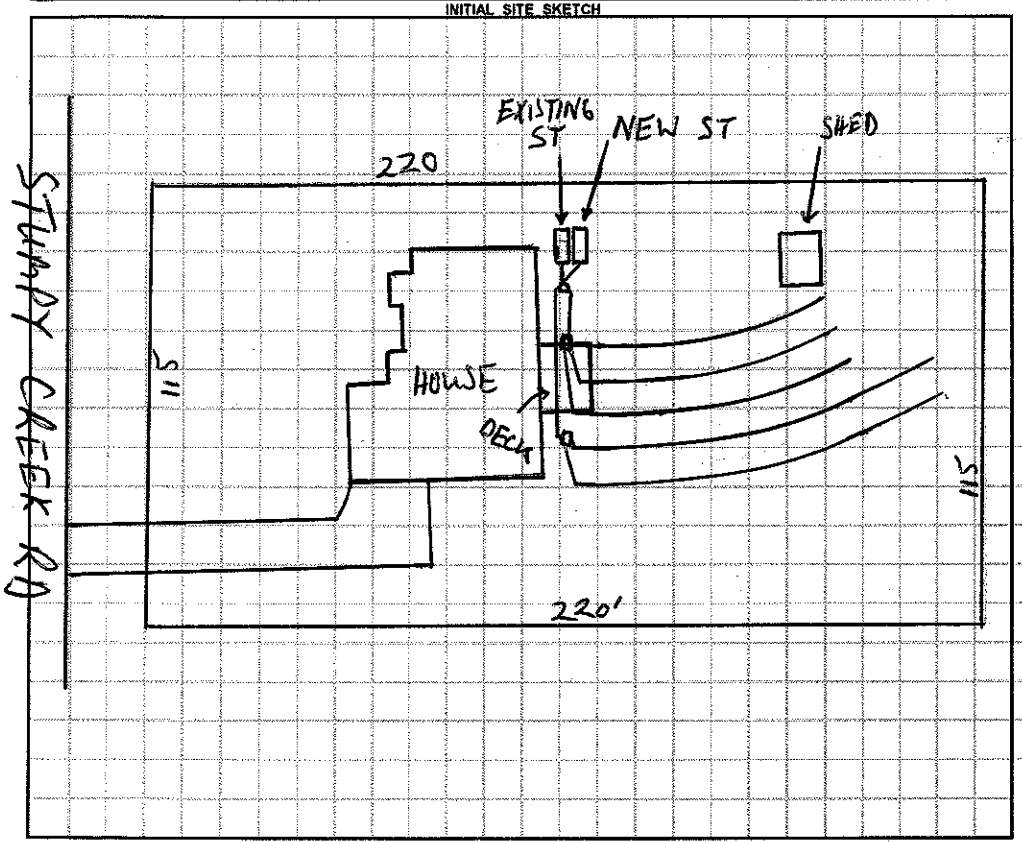

AS BUILT SKETCH

Permit can be suspended or revoked if any false information is supplied toward securing the permit / any unauthorized changes are made to the site / any unauthorized changes are made in the installation of the system. **CONTACT A LOCATOR SERVICE PRIOR TO ANY EXCAVATION**

☐ **IMPROVEMENT PERMIT** *with plat valid without expiration.* ☑ **IMPROVEMENT PERMIT** *with site plan valid for 60 mos.* ☐ **AUTHORIZATION TO CONSTRUCT** *valid for period equal to IMPROVEMENT PERMIT--not to exceed 60 mo.*

Owner / Applicant Signature: Michael Barricello Date: 7-2-14 Installed by: Jarrid Lowentz

IMPROVEMENT PERMIT by: [signature] Date: 7-1-14 OPERATION PERMIT by: [signature] RS Date: 7/11/14

AUTHORIZATION TO CONSTRUCT by: [signature] Date: 7-1-14 Existing System Inspected by: Date:

Health Dept. Copy - WHITE Applicant (Final Approval) - YELLOW Applicant (Conditional Approval) - PINK