9:30

IREDELL COUNTY HEALTH DEPARTMENT

STATESVILLE 704-878-5305 MOORESVILLE 704-664-5281

IMPROVEMENT PERMIT / CERTIFICATE OF COMPLETION / OPERATION PERMIT / EXISTING SYSTEM INSPECTION

PROPERTY DESCRIPTION NO. 23211 DATE Sept. 3, '96 TAX MAP NO. part of 25A80 Watershed: ☑ Yes ☐ No

OWNER OR CONTRACTOR James M. Harper PHONE: Business 478-3766 ~~Home~~ 4638-78-1974

ADDRESS 1651 Lake Front Dr. Catawba N.C.

LOCATION Path Rd. N. TL Stumpy Creek Rd. on left

SUBDIVISION Harborwood BLOCK / SECTION 7th LOT 7 LOT AREA .58Ac SITE CLASS. PS DESIGN FLOW 360gpd L.T.A.R. .03

Septic Tank: 1000 Gallons; STB 780 Date 7/29/97

Pump Tank: ____ Gallons; PT ____ Date ____

Pump Make: ____ Model ____ Serial No. ____

Nitrification Field: No Fields 2 Square Feet 1200 Linear Feet 400

No Lines 3+2 Trench Width 36" Max Trench Bottom Depth ~24" Gravel Depth 12"

☑ New System ☐ Repair System Type: I, (II), III, IV, V, VI

System Description: gravity conventional

Repair System Description: gravity-chambered

Maintenance Agreement Required: ☐ Yes ☐ No

☑ House/Mod. Home No. Bedrooms 3

☐ Mobile Home No. Bathrooms 2

☐ Business No. Employees ____

☐ Other ____

~~☑ Slab~~ ~~☑ Crawl Space~~ ☐ Basement w/plumbing ☐ Basement wo/plumbing


Water Supply:
☐ Individual
☑ Community
☑ Public

Comments: Tank & lines inspected mb
FD & D-boxes checked

Comments:

1" = 50'

INITIAL SITE SKETCH

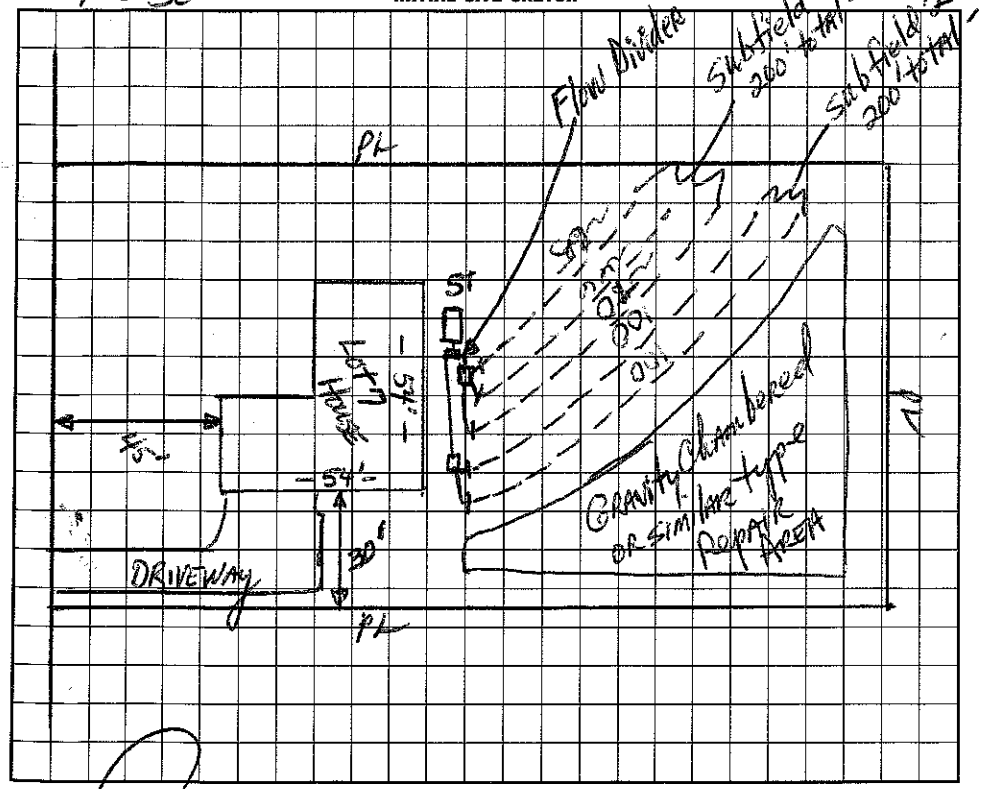

AS BUILT SKETCH

I understand that this permit can be suspended or revoked if any false information is supplied toward securing the permit/any unauthorized changes are made to the site/any unauthorized changes are made in the installation of the system.

Signed: James M. Harper

Improvement Permit by: David B. Harrison, RS date 9-3-96

~~Existing system inspection by:~~ Construction Authorization by: David B. Harrison, RS date 9-3-96

Installed by: Kennedy Grading

Certificate of Completion by: Maintenance Tech Carlson date 9/23/97

Operation Permit by: Maintenance Tech Carlson date 9/23/97

HEALTH DEPT. COPY: WHITE INSPECTION COPY (FINAL): GREEN OWNER COPY (FINAL): YELLOW INSPECTION COPY (INITIAL): PINK OWNER COPY (INITIAL): GOLD