IREDELL COUNTY HEALTH DEPARTMENT Const. Auth. - STATESVILLE 704-878-5305 MOORESVILLE 704-664-5281

IMPROVEMENT PERMIT / ~~CERTIFICATE OF COMPLETION~~ / OPERATION PERMIT / EXISTING SYSTEM INSPECTION

PROPERTY DESCRIPTION NO. 23210 DATE Sept 3, '96 TAX MAP NO. part of 25A80 Watershed: ☑ Yes ☐ No

OWNER OR CONTRACTOR James M. Harper PHONE: Business 478-3766 ~~Home~~ 4638-78-2998

ADDRESS 1651 Lakefront Dr. Catawba, N.C.

LOCATION South Rd. N. to Stumpy Creek Rd. 6th lot on left

SUBDIVISION Harborcrest BLOCK / SECTION II LOT 6 LOT AREA .65Ac SITE CLASS. PS DESIGN FLOW 360gpd L.T.A.R. .3

Septic Tank: 1000 Gallons; STB 786 Date 7/24/97

Pump Tank: _____ Gallons; PT _____ Date _____

Pump Make: _____ Model _____ Serial No. _____

Nitrification Field: No Fields 1 Square Feet 1200 Linear Feet 400

No Lines 3@133' Trench Width 36" Max Trench Bottom Depth ~24" Gravel Depth 12"

☑ New System ☐ Repair System Type: I, (II) III, IV, V, VI

System Description: gravity conventional

Repair System Description: gravity chambered/similar

Maintenance Agreement Required: ☐ Yes ☑ No

☑ House/Mod. Home No. Bedrooms 3

☐ Mobile Home No. Bathrooms 2

☐ Business No. Employees _____

☐ Other _____

☑ Slab ☑ Crawl Space ☐ Basement w/plumbing ☐ Basement wo/plumbing


Water Supply:
☐ Individual
☐ Community
☑ ~~Public~~

Comments:

Comments:

INITIAL SITE SKETCH

1"=50'

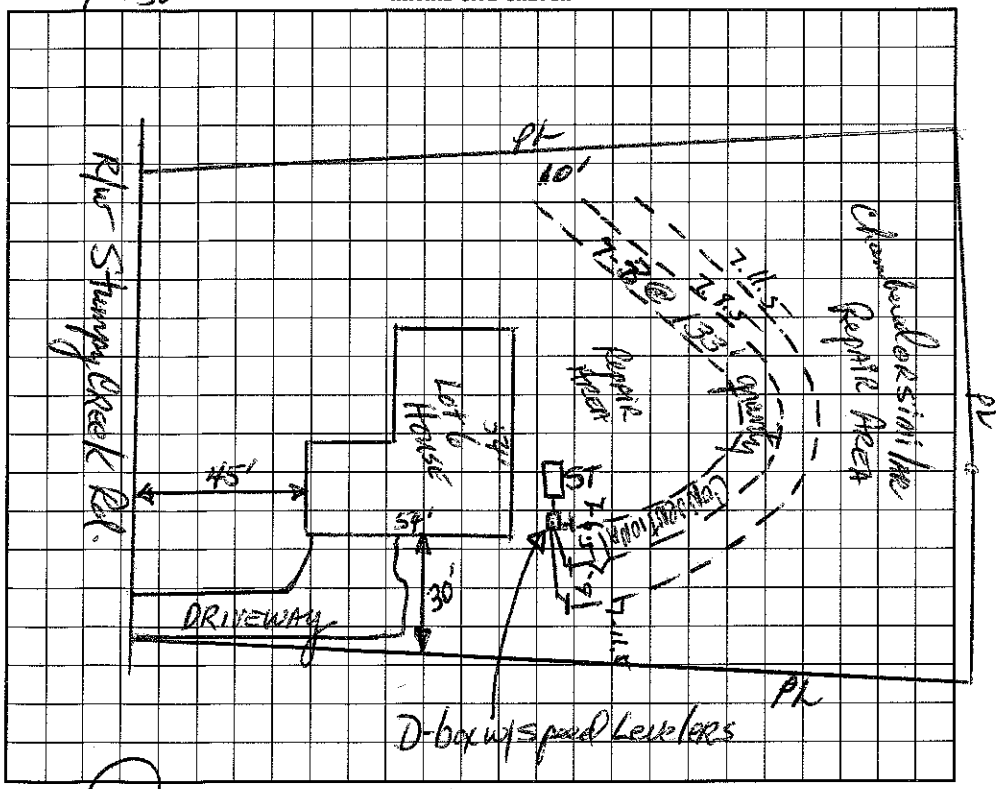

AS BUILT SKETCH

I understand that this permit can be suspended or revoked if any false information is supplied toward securing the permit/any unauthorized changes are made to the site/any unauthorized changes are made in the installation of the system.

Signed: James M. Harper

Improvement Permit by: D.R. Thurman IRS date 9-3-96

~~Construction Authorization~~ by: D.R. Thurman IRS date 9-3-96

Installed by: Kennedy Grading

Certificate of Completion by: Wesley Sparks RS. date 9/18/97

Operation Permit by: Wesley Sparks RS. date 9/18/97

HEALTH DEPT. COPY: WHITE INSPECTION COPY (FINAL): GREEN OWNER COPY (FINAL): YELLOW INSPECTION COPY (INITIAL): PINK OWNER COPY (INITIAL): GOLD