(3:00)

IREDELL COUNTY HEALTH DEPARTMENT

STATESVILLE 704-878-5305 MOORESVILLE 704-664-5281

IMPROVEMENT PERMIT / AUTHORIZATION TO CONSTRUCT / OPERATION PERMIT / EXISTING SYSTEM INSPECTION

PERMIT# 25375 PIN# 2514-51 4638-78-3258 DATE 1/15/98

OWNER OR CONTRACTOR STUMPY CREEK LLC PHONE: Business _____ Home _____

ADDRESS 614 N MAIN ST SALISBURY NC 28144

LOCATION PERTH RD - TL PAST HIDEAWAY (SEATRAIL DR) TR AVOCET CT - AT END

SUBDIVISION HARBORVIEW BLOCK / SECTION VII LOT 25 LOT AREA .816 AC SITE CLASS. FS DESIGN FLOW 480 GPD L.T.A.R. .3 6-10/FT

Septic Tank: 1000 Gallons; STB 825 Date 2/21/98
Pump Tank: _____ Gallons; PT _____ Date _____
Pump Make: _____ Model _____ Serial No. _____
Nitrification Field: No Fields 1 Square Feet 900 Linear Feet 300
No Lines 2 @ 150' Trench Width 36" Max Trench Bottom Depth 36" Gravel Depth N/A

☑ New System ☐ Repair System Type: I, II, III, IV, V, VI
System Description: GRAVITY CHAMBERED OR HDS
Repair System Description: PANEL
Maintenance Agreement Required: ☐ Yes ☑ No


☑ House/Mod. Home No. Bedrooms 3
☐ Mobile Home No. Bathrooms 2
☐ Business No. Employees _____
☐ Other _____
☐ Slab ☑ Crawl Space ☐ Basement w/plumbing ☐ Basement wo/plumbing

Water Supply: ☐ Individual ☐ Public ☑ Community

Comments:/Conditions:

Comments:/Conditions:

INITIAL SITE SKETCH

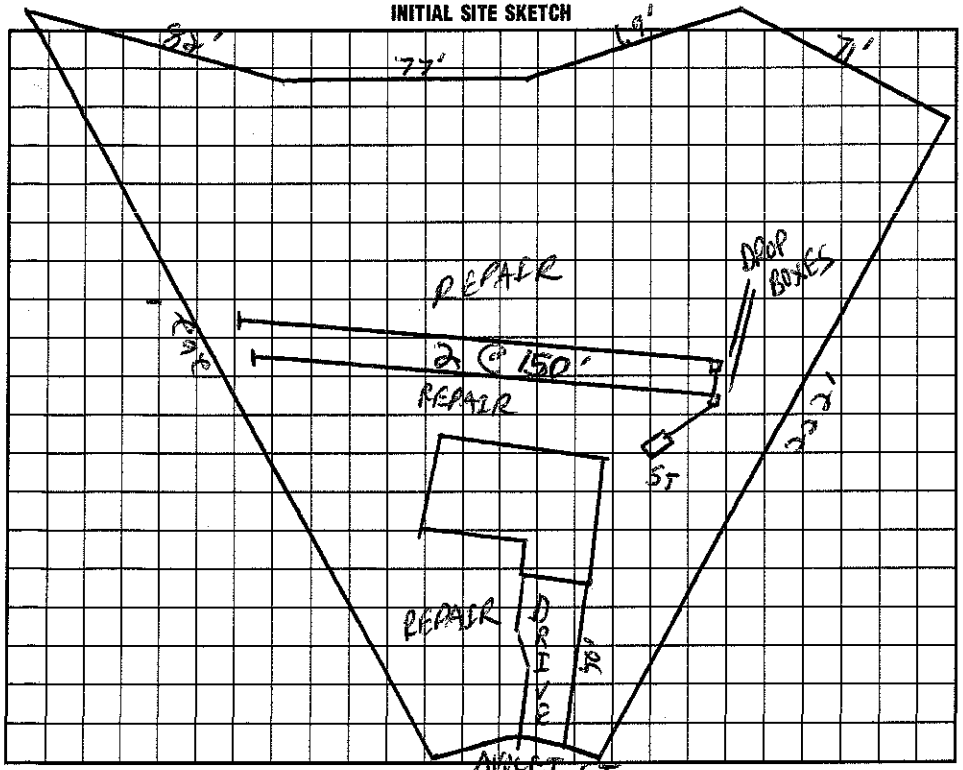

AS BUILT SKETCH

I understand that this permit can be suspended or revoked if any false information is supplied toward securing the permit/any unauthorized changes are made to the site/any unauthorized changes are made in the installation of the system. Improvement Permit with plat valid without expiration. Improvement Permit with site plan valid for sixty months. Authorization to Construct is valid for a period equal to that of Improvement Permit – not to exceed sixty months.

Signed: _____ date 2-05-98 Installed by: ROWAN SEPTIC

Improvement Permit by: C. Ray Freeman date 1/15/98 Operation Permit by: C. Ray Freeman date 6/22/98

Authorization to Construct by: C. Ray Freeman date 1/15/98 Existing System Inspection by: _____ date _____

HEALTH DEPT. COPY: WHITE INSPECTION COPY (FINAL): GREEN OWNER COPY (FINAL): YELLOW INSPECTION COPY (INITIAL): PINK OWNER COPY (INITIAL): GOLD