IREDELL COUNTY HEALTH DEPARTMENT

STATESVILLE 704-878-5305 MOORESVILLE 704-664-5281

IMPROVEMENT PERMIT / AUTHORIZATION TO CONSTRUCT / OPERATION PERMIT / EXISTING SYSTEM INSPECTION

PERMIT# 066566 PIN# ~~4638777776~~ 4638-78-3727 DATE May 19 '98

OWNER OR CONTRACTOR Stumpy Creek LLC PHONE: Business 633-6124 Home

ADDRESS 664 N. Main St Salisbury

LOCATION South Rd. N. TL TANAGER on Right at end

SUBDIVISION Harborview BLOCK / SECTION VIII LOT 10 LOT AREA .62Ac SITE CLASS. PS DESIGN FLOW 360gpd L.T.A.R. .3

Septic Tank: 1000 Gallons; STB 825 Date 6/1/98
Pump Tank: Gallons; PT Date
Pump Make: Model Serial No.
Nitrification Field: No Fields 1 Square Feet 900 Linear Feet 300
No Lines ~~4~~ 5 Trench Width 36" Max Trench Bottom Depth 36" Gravel Depth NA.

☑ New System ☐ Repair System Type: I, II, III, IV, V, VI
System Description: Gravity Modified 25% Red.
Repair System Description: Gravity Pumped Modified
Maintenance Agreement Required: ☐ Yes ☑ No

☐ House/Mod. Home No. Bedrooms 3
☐ Mobile Home No. Bathrooms 2
☐ Business No. Employees
☐ Other
☐ Slab ☑ Crawl Space ☐ Basement w/plumbing ☐ Basement wo/plumbing


Water Supply:
☐ Individual
☐ Public
☑ Community

Comments:/Conditions: * ONE INSPECTION/OBSERVATION PORT PER LATERAL
CAN USE D-box w/speed levelers OR Drop Boxes

Comments:/Conditions:

1"=60'

INITIAL SITE SKETCH

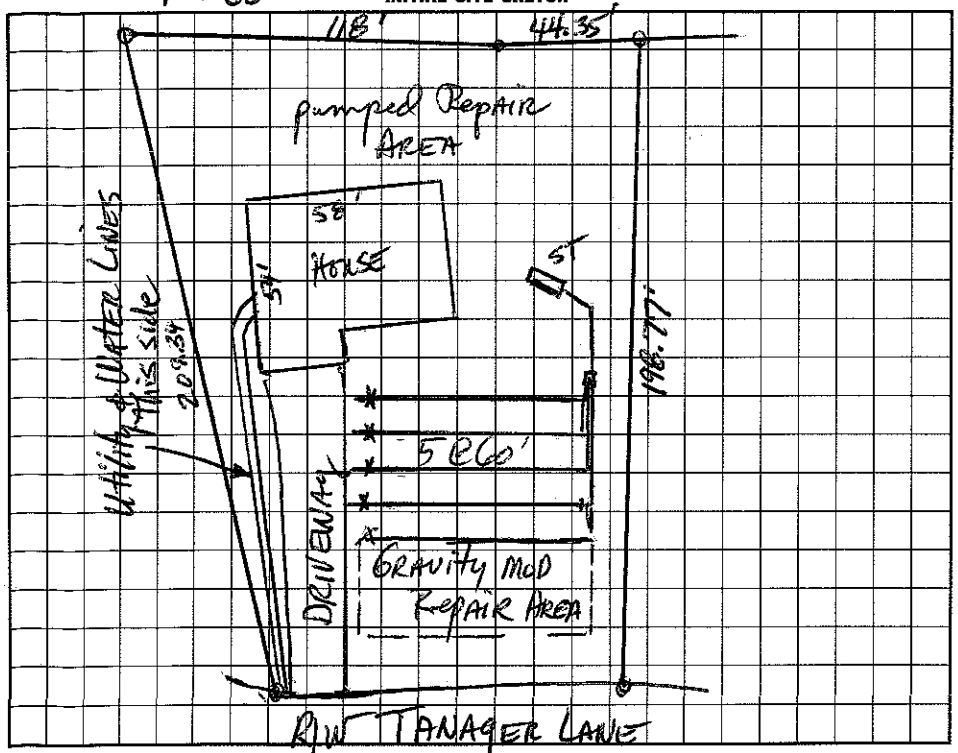

AS BUILT SKETCH

I understand that this permit can be suspended or revoked if any false information is supplied toward securing the permit/any unauthorized changes are made to the site/any unauthorized changes are made in the installation of the system. Improvement Permit with plat valid without expiration. Improvement Permit with site plan valid for sixty months. Authorization to Construct is valid for a period equal to that of Improvement Permit – not to exceed sixty months.

Signed: * date 5/19/98 Installed by: ROWAN SEPTIC

Improvement Permit by: David R. Thomas RS date 5-19-98 Operation Permit by: C. Ky Thomas RS date 9/9/98

Authorization to Construct by: David R. Thomas RS date 5-19-98 Existing System Inspection by: date

HEALTH DEPT. COPY: WHITE INSPECTION COPY (FINAL): GREEN OWNER COPY (FINAL): YELLOW INSPECTION COPY (INITIAL): PINK OWNER COPY (INITIAL): GOLD