IREDELL COUNTY HEALTH DEPARTMENT

STATESVILLE 704-878-5305 MOORESVILLE 704-664-5281

IMPROVEMENT PERMIT / AUTHORIZATION TO CONSTRUCT / OPERATION PERMIT / EXISTING SYSTEM INSPECTION

PERMIT# 046562 PIN# 4638 77 1716 4638 78 4511 DATE 10/5/98

OWNER OR CONTRACTOR Dem. Custom Homes LLC PHONE: Business 597-1461 Home

ADDRESS 4516 New Linden Ct. Charlotte, NC. 28215

LOCATION Perth Rd. N, TL Tanager Lane on (D) at cul de sac

SUBDIVISION HARBORVIEW BLOCK / SECTION 8 LOT 3,4,5,6 LOT AREA ~ 2.4 AC SITE CLASS. RS DESIGN FLOW 360 L.T.A.R. .3

Septic Tank: 1000 Gallons; STB 312 Date 12/5/99
Pump Tank: 1000 Gallons; PT 27 Date 11/30/99
Pump Make: MYERS Model ME-3F Serial No.
Nitrification Field: No Fields 1 Square Feet 1200 Linear Feet 400
No Lines 4 Trench Width 36" Max Trench Bottom Depth 30" Gravel Depth 12"

[X] New System [ ] Repair System Type: I, II, (III) IV, V, VI
System Description: Pres Man – Conventional
Repair System Description: Same
Maintenance Agreement Required: [ ] Yes [X] No


[X] House/Mod. Home No. Bedrooms 3
[ ] Mobile Home No. Bathrooms 2
[ ] Business No. Employees
[ ] Other
[ ] Slab [ ] Crawl Space [X] Basement w/plumbing [ ] Basement wo/plumbing

Water Supply: [ ] Individual [ ] Public [X] Community


Comments:/Conditions: 2/7/00 May use 300 feet of EZ Lay in place of conventional – Aws (1" = 60')

Comments:/Conditions: Tanks, Drainlines, Drainfield (EZ LAY)

INITIAL SITE SKETCH

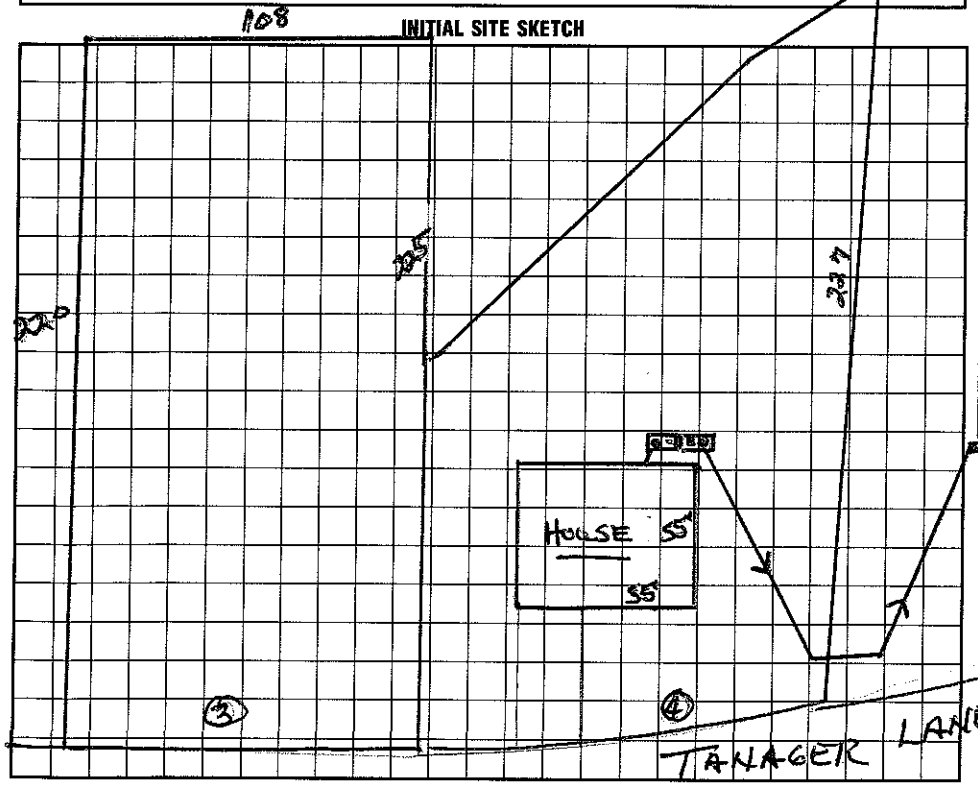

AS BUILT SKETCH

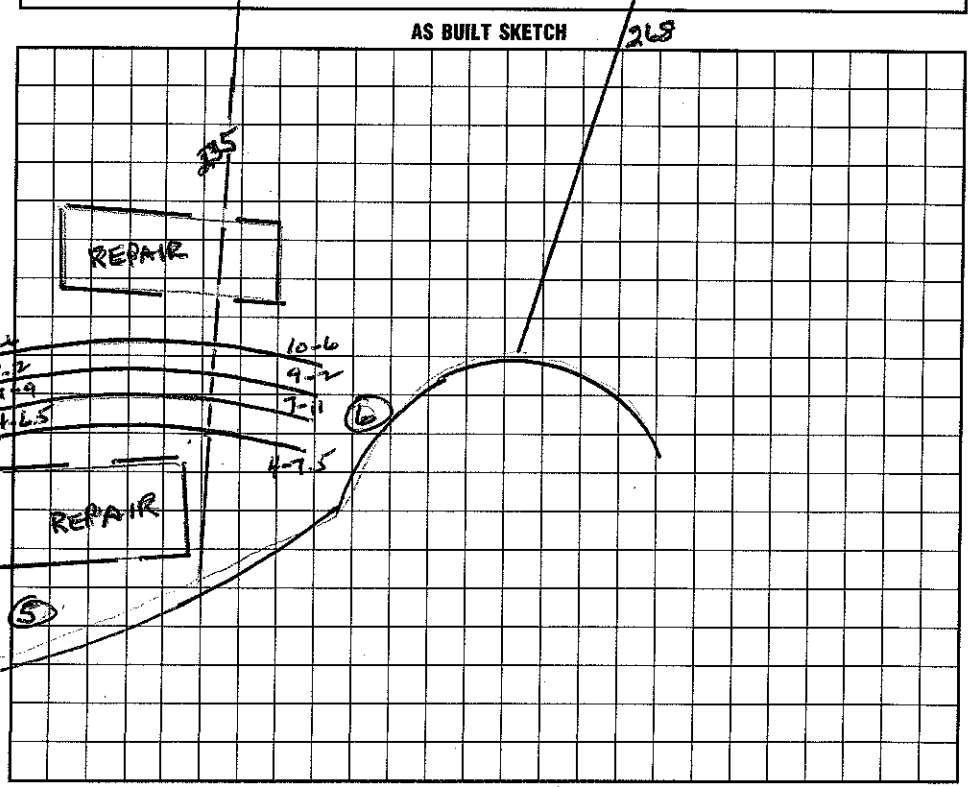

I understand that this permit can be suspended or revoked if any false information is supplied toward securing the permit/any unauthorized changes are made to the site/any unauthorized changes are made in the installation of the system. Improvement Permit with plat valid without expiration. Improvement Permit with site plan valid for sixty months. Authorization to Construct is valid for a period equal to that of Improvement Permit – not to exceed sixty months.

Signed: * L. Carlo McKoy date 2/9/99 Installed by: H+R Inc

Improvement Permit by: Wesley Sparks RS. date 10/5/98 Operation Permit by: Wesley Sparks RS. date 3/6/00

Authorization to Construct by: Wesley Sparks RS. date 10/5/98 Existing System Inspection by: date

HEALTH DEPT. COPY: WHITE INSPECTION COPY (FINAL): GREEN OWNER COPY (FINAL): YELLOW INSPECTION COPY (INITIAL): PINK OWNER COPY (INITIAL): GOLD