IREDELL COUNTY HEALTH DEPARTMENT

STATESVILLE 704-878-5305 MOORESVILLE 704-664-5281

IMPROVEMENT PERMIT / CERTIFICATE OF COMPLETION / OPERATION PERMIT / EXISTING SYSTEM INSPECT.

PROPERTY DESCRIPTION NO. 25377 DATE 2/10/97 TAX MAP NO. 25-A-51 Pt 1 Watershed: ☑ Yes ☐ No

OWNER OR CONTRACTOR STUMPY CREEK LLC PHONE: Business 633-6124 Home

ADDRESS 614 MAIN ST SALISBURY NC 28144

LOCATION PERTH RD - TR 1ST RD PAST STUMPY CREEK - 400 SEA TRAIL DR - TR AVOCET CT.

SUBDIVISION HARBVIEW BLOCK / SECTION 7 LOT 27 LOT AREA .535 AC SITE CLASS. PS DESIGN FLOW 450 GPD L.T.A.R. .3 GPD/FT²

Septic Tank: 1000 Gallons; STB Date

Pump Tank: Gallons; PT Date

Pump Make: Model Serial No.

Nitrification Field: No Fields 1 Square Feet 1200 Linear Feet 400

No Lines 4 @ 100' Trench Width 36" Max Trench Bottom Depth 36" ~~Gravel Depth~~ N/A

☑ New System ☐ Repair System Type: I, II, III, IV, V, VI

System Description: GRAVITY CHAMBERED

Repair System Description: PANEL

Maintenance Agreement Required: ☐ Yes ☑ No

☑ House/Mod. Home No. Bedrooms 4

☐ Mobile Home No. Bathrooms 4

☐ Business No. Employees

☐ Other

☐ Slab ☑ Crawl Space ☐ Basement w/plumbing ☐ Basement wo/plumbing


Water Supply: ☐ Individual ☑ Community ☐ Public

Comments:


Comments: IMPROVEMENT PERMIT ONLY - DO NOT ISSUE BUILDING PERMIT.

(GRAVITY CONV.)

INITIAL SITE SKETCH 1" = 60'

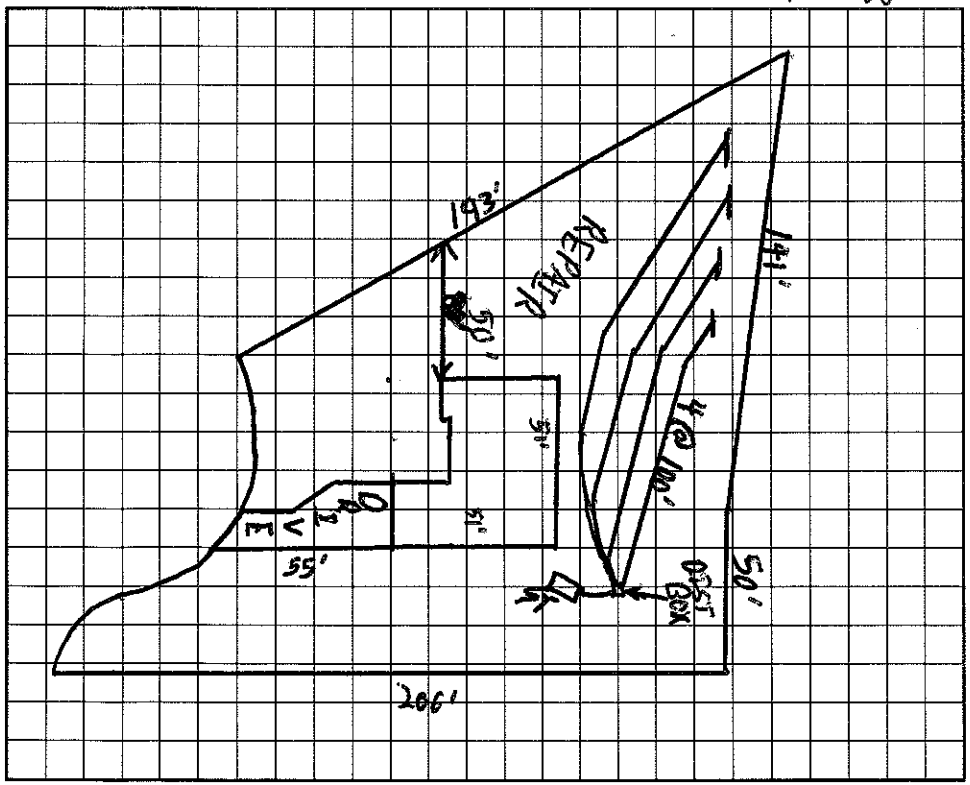

AS BUILT SKETCH

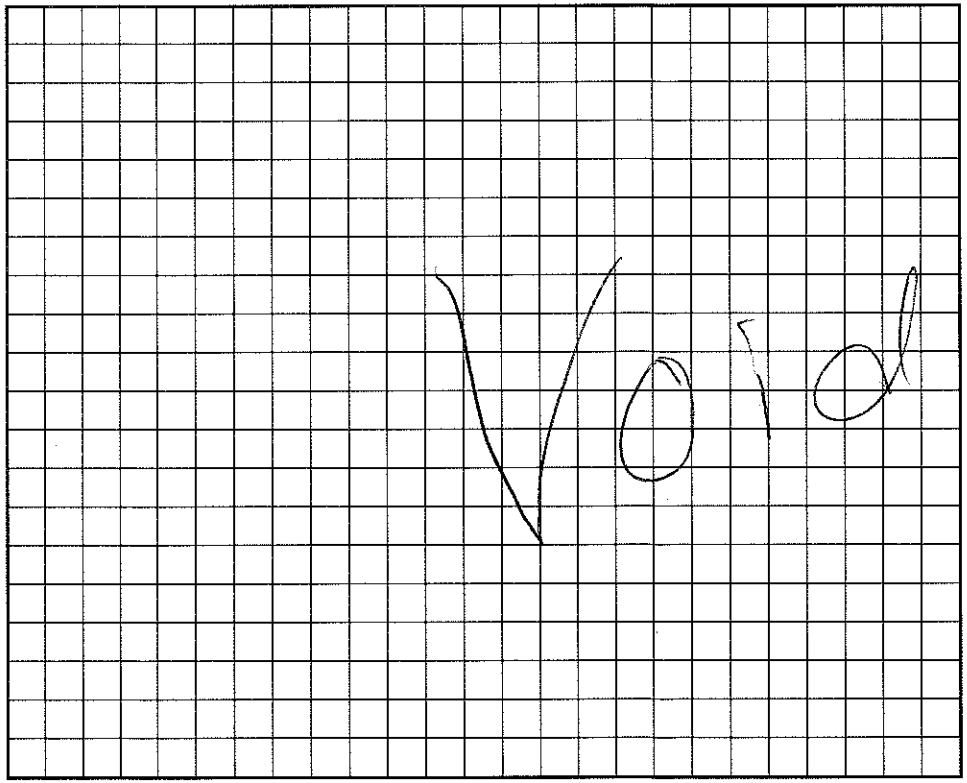

I understand that this permit can be suspended or revoked if any false information is supplied toward securing the permit/any unauthorized changes are made to the site/any unauthorized changes are made in the installation of the system. Improvement Permit is valid for 60 months from date of issuance.

Signed:

Improvement Permit by: C Ray Ferrell EHSI date 2/10/97

Existing System Inspection by: date

Installed by:

Certificate of Completion by: date

Operation Permit by: date

HEALTH DEPT. COPY: WHITE INSPECTION COPY (FINAL): GREEN OWNER COPY (FINAL): YELLOW INSPECTION COPY (INITIAL): PINK OWNER COPY (INITIAL): GOLD