IREDELL COUNTY HEALTH DEPARTMENT

STATESVILLE 704-878-5305 MOORESVILLE 704-664-5281

(3.30)

IMPROVEMENT PERMIT / AUTHORIZATION TO CONSTRUCT / OPERATION PERMIT / EXISTING SYSTEM INSPECTION

PERMIT# 25377 PIN# 25 A 51 Pt of 4638785166 DATE 6/22/98

OWNER OR CONTRACTOR LAKEMONT HOMES PHONE: Business 339-7998 Home

ADDRESS PO BOX 1463 MATTHEWS 28105

LOCATION PERTH RD - TL SEATRAIL - TR AVOCET CT AT END

SUBDIVISION HARBORVIEW BLOCK / SECTION III LOT 27 LOT AREA .538 AC SITE CLASS. 1S DESIGN FLOW 360 GPD L.T.A.R. .36 PD

Septic Tank: 1000 Gallons; STB 794 Date 3/13/98

Pump Tank: Gallons; PT Date

Pump Make: Model Serial No.

Nitrification Field: No Fields 1 Square Feet 900 Linear Feet 300

No Lines 4 Trench Width 36" Max Trench Bottom Depth 36" Gravel Depth

☑ New System ☐ Repair System Type: I, II, (III), IV, V, VI

System Description: GRAVITY CHAMBERS ORHD

Repair System Description: PUMP PANEL

Maintenance Agreement Required: ☐ Yes ☑ No

☑ House/Mod. Home No. Bedrooms 3

☐ Mobile Home No. Bathrooms 3

☐ Business No. Employees

☐ Other


☐ Slab ☑ Crawl Space ☐ Basement w/plumbing ☐ Basement wo/plumbing

Wat: ☐ Ind. ☐ Public ☑ Community

Comments:/Conditions:

Comments:/Conditions:

INITIAL SITE SKETCH 1"=60'

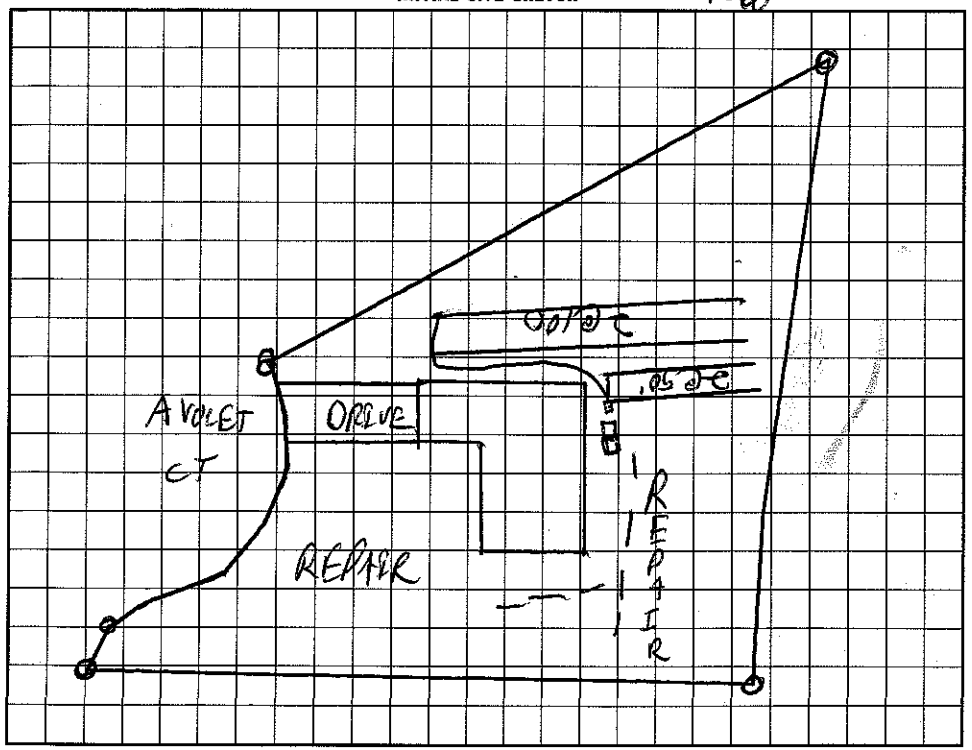

AS BUILT SKETCH

I understand that this permit can be suspended or revoked if any false information is supplied toward securing the permit/any unauthorized changes are made to the site/any unauthorized changes are made in the installation of the system. Improvement Permit with plat valid without expiration. Improvement Permit with site plan valid for sixty months. Authorization to Construct is valid for a period equal to that of Improvement Permit – not to exceed sixty months.

Signed: date

Improvement Permit by: C. [signature] ES date 6/22/98

Authorization to Construct by: [signature] RS date 6/23/98

Installed by: LARRY BEAM

Operation Permit by: [signature] date 6/22/98

Existing System Inspection by: date

HEALTH DEPT. COPY: WHITE INSPECTION COPY (FINAL): GREEN OWNER COPY (FINAL): YELLOW INSPECTION COPY (INITIAL): PINK OWNER COPY (INITIAL): GOLD