IREDELL COUNTY HEALTH DEPARTMENT

STATESVILLE 704-878-5305 MOORESVILLE 704-664-5281

IMPROVEMENT PERMIT / AUTHORIZATION TO CONSTRUCT / OPERATION PERMIT / EXISTING SYSTEM INSPECTION

PERMIT# 143201 PIN# 4638 78 5324 DATE 6-20-07

OWNER OR APPLICANT Atkinson Custom Homes LLC PHONE: Business 506-9074 Home

ADDRESS 490 River Ridge Lane Lexington, NC 27295

LOCATION Perth Rd TL Sea Trail TR Avocet Ct at End

SUBDIVISION Harborview BLOCK / SECTION 7 LOT 26 LOT AREA 1.037 Acre SITE CLASS. PS DESIGN FLOW 480 gpd L.T.A.R. .3

Septic Tank: 1000 Gallons: STB 827 Date 7-2-07
Pump Tank: Gallons: PT Date
Pump Make: Model Serial No.
Nitrification Field: No Fields 1 Square Feet 1600' Linear Feet 533'
No Lines 4@133' Trench Width 36" Max Trench Bottom Depth 36" Gravel Depth 12"

☒ New System ☐ Repair ☐ Expansion System Type: I ☒ II III IV V VI
System Description: Gravity - Conventional
Repair System Description: Gravity - 25% Reduction
Maintenance Agreement Required: ☐ Yes ☒ No

☒ Gravity ☐ Pressure ☐ Slab ☒ Crawl Space ☐ Basement w/plumbing ☐ Basement wo/plumbing


☒ House/Mod. Home No. Bedrooms 4
☐ Mobile Home No. Persons
☐ Business No. Employees
☐ Other

Water Supply: ☐ Individual ☒ Public ☒ Community

Comments/Conditions: Note: Okay to Install 4 lines @ 100ft eq 25% Reduction.

Comments/Conditions: 7/25/07 Installed Quick 4 with 11 "built in" drop boxes 400 100ft eq

Scale 1:100 INITIAL SITE SKETCH

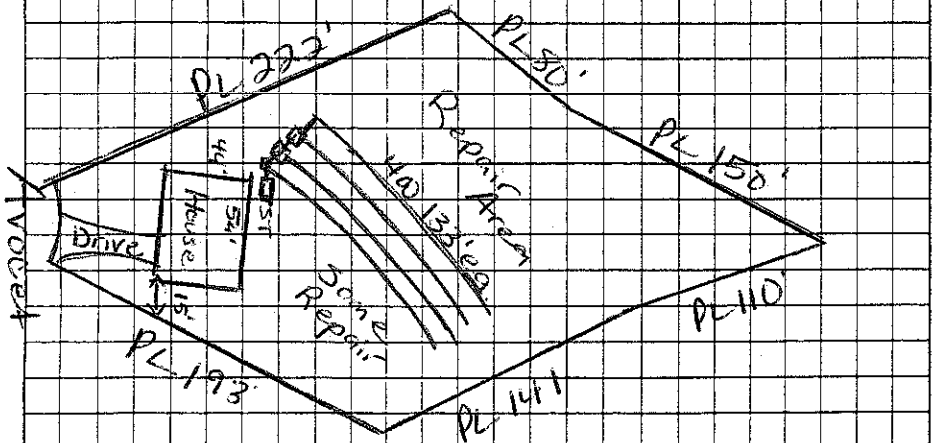

AS BUILT SKETCH

Permit can be suspended or revoked if any false information is supplied toward securing the permit/any unauthorized changes are made to the site/any unauthorized changes are made in the installation of the system. Improvement Permit with plat valid without expiration ☐ Improvement Permit with site plan valid for sixty months ☐ Authorization to Construct is valid for a period equal to that of Improvement Permit – not to exceed sixty months.

Signed: date 6/26/07 Installed by: Rowan Septic

Improvement Permit by: Maria H. Dotson RS date 6/20/07 Operation Permit by: Maria H. Dotson RS date 9/25/07

Authorization to Construct by: Maria H. Dotson RS date 6/20/07 Existing System Inspection by: date

HEALTH DEPT. COPY: WHITE OWNER COPY (FINAL): YELLOW OWNER COPY (INITIAL): PINK