4:00

IREDELL COUNTY HEALTH DEPARTMENT

STATESVILLE 704-878-5305 MOORESVILLE 704-664-5281

IMPROVEMENT PERMIT / AUTHORIZATION TO CONSTRUCT / OPERATION PERMIT / EXISTING SYSTEM INSPECTION

PERMIT# 066568 PIN# 4638 77 1716 4638 78 6876 DATE 2/26/98

OWNER OR CONTRACTOR Carroll Fisher Const. PHONE: Business 633-6124 Home

ADDRESS 614 N Main St Salisbury, NC 28039

LOCATION Peeler Rd N, TL Tanger to 1st lot on (R)

SUBDIVISION HARBOR VIEW BLOCK / SECTION 2 LOT 12 LOT AREA .75AC SITE CLASS. PS DESIGN FLOW 360 L.T.A.R. .3

Septic Tank: 1000 Gallons; STB 825 Date 6/2/98
Pump Tank: 1000 Gallons; PT 47 Date 6/22/98
Pump Make: ZOELLER Model Serial No.
Nitrification Field: No Fields 1 Square Feet 900± Linear Feet 300±
No Lines 3 Trench Width 36" Max Trench Bottom Depth 30" Gravel Depth SAND

[X] New System ☐ Repair System Type: I, II, (III), IV, V, VI
System Description: Presbyter — CH Plastic
Repair System Description: Same
Maintenance Agreement Required: ☐ Yes [X] No


[X] House/Mod. Home No. Bedrooms 3
☐ Mobile Home No. Bathrooms 2
☐ Business No. Employees
☐ Other
☐ Slab [X] Crawl Space ☐ Basement w/plumbing ☐ Basement wo/plumbing

Water Supply: ☐ Individual ☐ Public [X] Community

Comments:/Conditions:

Comments:/Conditions:

INITIAL SITE SKETCH

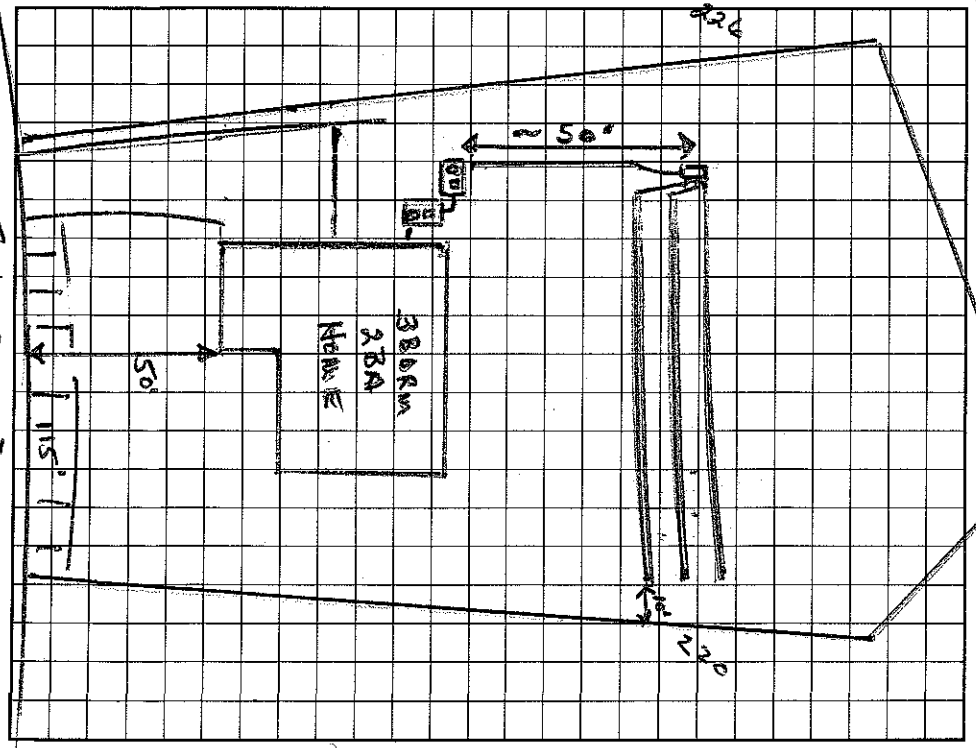

AS BUILT SKETCH

I understand that this permit can be suspended or revoked if any false information is supplied toward securing the permit/any unauthorized changes are made to the site/any unauthorized changes are made in the installation of the system. Improvement Permit with plat valid without expiration. Improvement Permit with site plan valid for sixty months. Authorization to Construct is valid for a period equal to that of Improvement Permit – not to exceed sixty months.

Signed: [signature] date

Improvement Permit by: Wesley Sparks RS. date 2/26/98

Authorization to Construct by: Wesley Sparks RS. date 2/26/98

Installed by: ROWAN SEPTIC

Operation Permit by: [signature] date 8/26/98

Existing System Inspection by: date

HEALTH DEPT. COPY: WHITE INSPECTION COPY (FINAL): GREEN OWNER COPY (FINAL): YELLOW INSPECTION COPY (INITIAL): PINK OWNER COPY (INITIAL): GOLD