IREDELL COUNTY HEALTH DEPARTMENT

STATESVILLE 704-878-5305 [redacted] 704-664-5281

IMPROVEMENT PERMIT / AUTHORIZATION TO CONSTRUCT / OPERATION PERMIT / EXISTING SYSTEM INSPECTION

PERMIT# 066569 PIN# ~~4638 97 4716~~ 4638 78 6884 DATE Feb 5, '98

OWNER OR CONTRACTOR ~~Thompson Custom Homes LLC~~ HARPER CONST PHONE: Business 633-6124 Home

ADDRESS 614 N. Main St Salisbury N.C. 28144

LOCATION Faith Rd N. TL Tanager Lane 2nd Lot on Right 110 Tanager Ln

SUBDIVISION Hardwicke BLOCK / SECTION VIII LOT 13 LOT AREA .56 SITE CLASS. PS DESIGN FLOW 360gpd L.T.A.R. .3

Septic Tank: 1000 Gallons; STB 825 Date 1/4/01
Pump Tank: 1000 Gallons; PT 302 Date 11/15/00
Pump Make: Model Serial No.
Nitrification Field: No Fields 1 Square Feet 900 Linear Feet 300
No Lines 3@100' Trench Width 36" Max Trench Bottom Depth 36" Gravel Depth N/A

☑ New System ☐ Repair System Type: I, II, (III) IV, V, VI
System Description: pumped-pre-Modified 25% Reduction
Repair System Description: LP Panel Block
Maintenance Agreement Required: ☐ Yes ☑ No

☑ House/Mod. Home No. Bedrooms 3
☐ Mobile Home No. Bathrooms 2
☐ Business No. Employees
☐ Other


☐ Slab ☑ Crawl Space ☐ Basement w/plumbing ☐ Basement wo/plumbing

Water Supply: ☐ Individual ☐ Public ☑ Community


Comments:/Conditions: * ONE inspection/observation port per LATERAL
Modify drainage pattern by filling Low AREA and installing Stormwater ditch Along 13/14 Side property LINE -

Comments:/Conditions:

INITIAL SITE SKETCH (1" = 60')

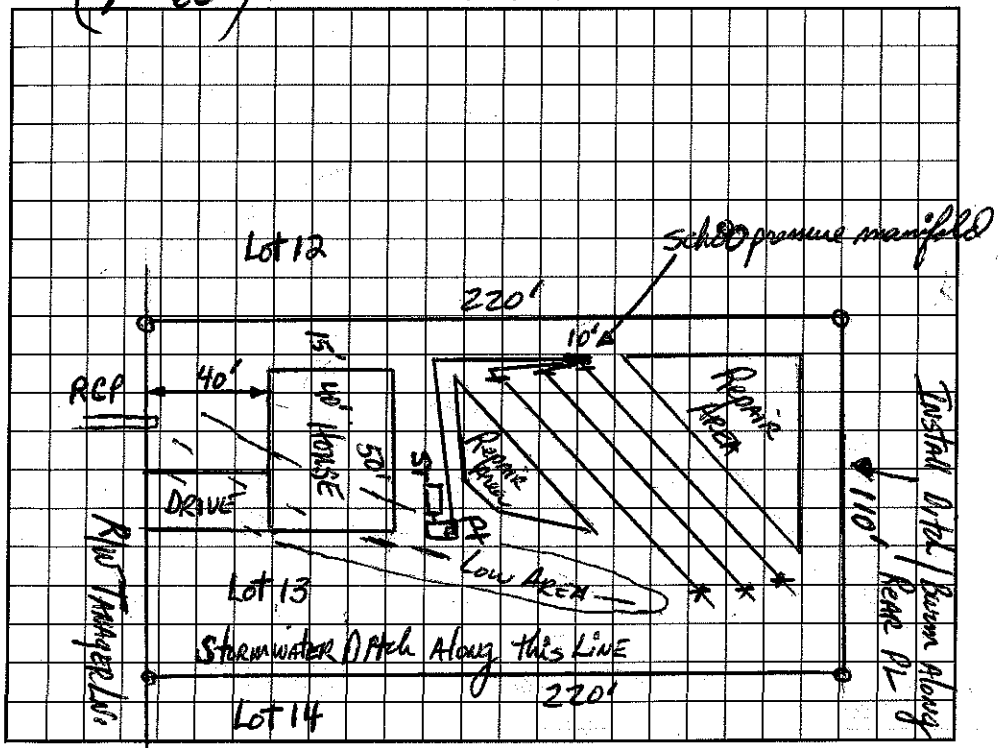

AS BUILT SKETCH

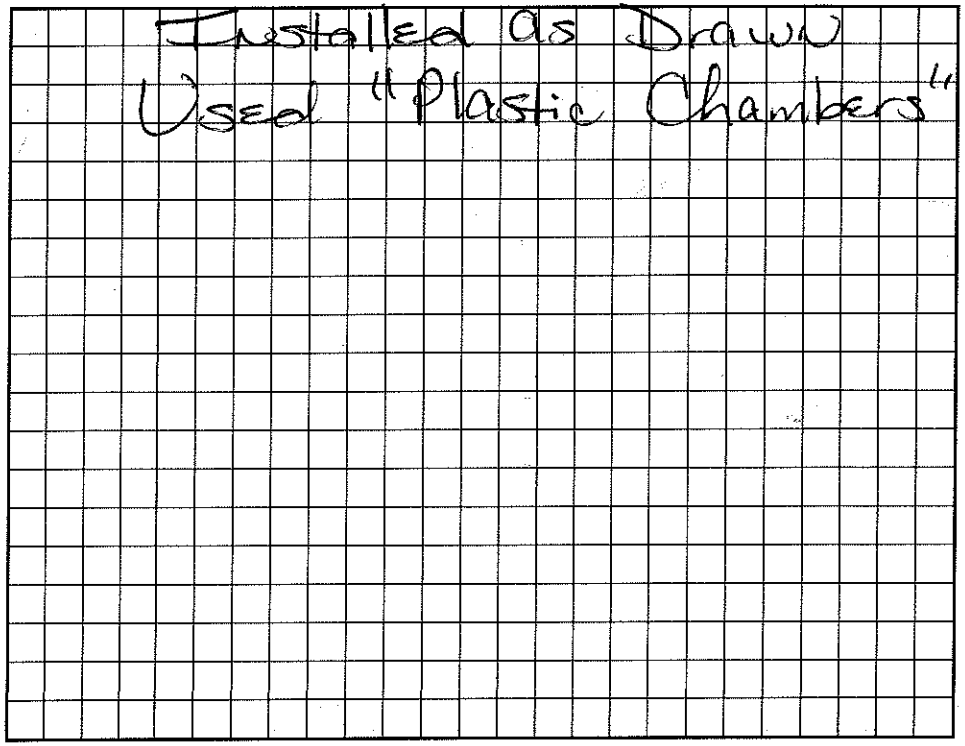

I understand that this permit can be suspended or revoked if ~~any false~~ information is supplied toward securing the permit/any unauthorized changes are made to the site/any unauthorized changes are made in the installation of the system. Improvement Permit with plat valid without expiration. Improvement Permit with site plan valid for sixty months. Authorization to Construct is valid for a period equal to that of Improvement Permit – not to exceed sixty months.

Signed: * date

Improvement Permit by: David R Thuson, RS date 2-5-98

Authorization to Construct by: Wesley Sparks R.S. date 10/22/98

Installed by: Wayne Clontz RS

Operation Permit by: Maria H Hess RS date 4/9/2001

Existing System Inspection by: date

HEALTH DEPT. COPY: WHITE INSPECTION COPY (FINAL): GREEN OWNER COPY (FINAL): YELLOW INSPECTION COPY (INITIAL): PINK OWNER COPY (INITIAL): GOLD