3:30

IREDELL COUNTY HEALTH DEPARTMENT

STATESVILLE 704-878-5305 MOORESVILLE 704-664-5281

IMPROVEMENT PERMIT / CERTIFICATE OF COMPLETION / OPERATION PERMIT / EXISTING SYSTEM INSPECTION

PROPERTY DESCRIPTION NO. 25380 DATE 1/21/97 TAX MAP NO. 25-A-51 pt 4 Watershed: ☑ Yes ☐ No

OWNER OR CONTRACTOR STUMPY CREEK LLC ~~PHONE: Business~~ 4638-78-7039 Home

ADDRESS 614 N MAIN ST SALISBURY NC 28144

LOCATION 150 W- TR PERTH RD -TL SEATRAIL - 2ND LOT ON RT 360 GPD

SUBDIVISION HARBOR VIEW BLOCK / SECTION 7 LOT 30 LOT AREA .667AC SITE CLASS. RS DESIGN FLOW ~~450 GPD~~ L.T.A.R. .30-.50/FT

Septic Tank: 1000 Gallons; STB 825 Date 5/19/97

Pump Tank: Gallons; PT Date

Pump Make: Model Serial No.

Nitrification Field: No Fields 1 Square Feet 1200 Linear Feet 400

No Lines 4@100' Trench Width 36" Max Trench Bottom Depth 36" ~~Gravel Depth~~ SAND

☑ New System ☐ Repair System Type: I, II, III, IV, V, VI

System Description: GRAVITY CHAMBERED

Repair System Description: PUMP/GRAVITY PANEL

Maintenance Agreement Required: ☐ Yes ☑ No

☑ House/Mod. Home No. Bedrooms 3-4

☐ Mobile Home No. Bathrooms 3

☐ Business No. Employees

☐ Other


☐ Slab ☑ Crawl Space ☐ Basement w/plumbing ☐ Basement wo/plumbing

Water Supply: ☐ Individual ☑ Community ☐ Public

Comments:

Comments: ~~IP ONLY - DO NOT ISSUE BUILDING PERMIT~~ CHANGED TO 3BR - SYSTEM TYPE CHANGED TO CONVENTIONAL TYPE II

INITIAL SITE SKETCH 1"=60'

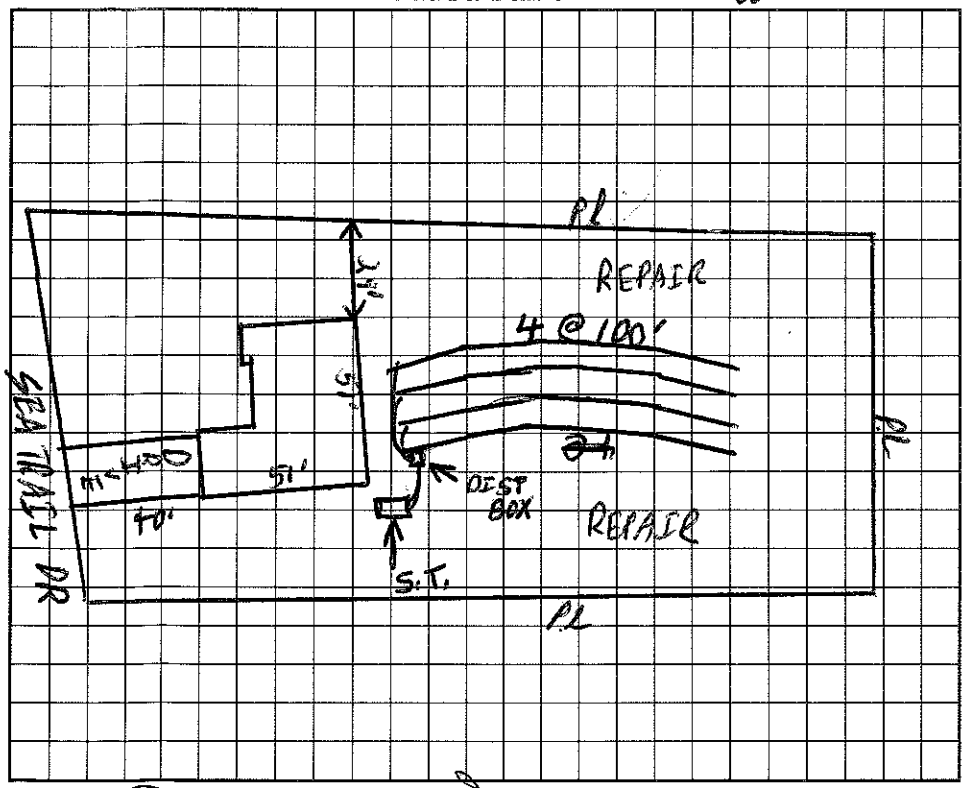

AS BUILT SKETCH

Same as Sketch

I understand that this permit can be suspended or revoked if any false information is supplied toward securing the permit/any unauthorized changes are made to the site/any unauthorized changes are made in the installation of the system. Improvement Permit is valid for 60 months from date of issuance.

Signed:

Improvement Permit by: C. [signature] date 1/21/97

~~Existing System Inspection by:~~ AUTHORIZATION TO CONSTRUCT C. [signature] date 4/21/97

Installed by: ROWAN SEPTIC

Certificate of Completion by: date

Operation Permit by: C. [signature] date 5/14/97

HEALTH DEPT. COPY: WHITE INSPECTION COPY (FINAL): GREEN OWNER COPY (FINAL): YELLOW INSPECTION COPY (INITIAL): PINK OWNER COPY (INITIAL): GOLD