$ 350

# IREDELL COUNTY HEALTH DEPARTMENT

STATESVILLE 704-878-5305 MOORESVILLE 704-664-5281

## IMPROVEMENT PERMIT / AUTHORIZATION TO CONSTRUCT / OPERATION PERMIT / EXISTING SYSTEM INSPECTION

PERMIT# 134896 PIN# 4638787586 DATE 4/26/06

OWNER OR APPLICANT D.A. Johnson Construction LLC PHONE: Business 400-5066 Home

ADDRESS P.O. Box 1065 Huntersville, NC 28070

LOCATION Perth Rd North TL Tanager property on left

SUBDIVISION Harborview BLOCK / SECTION 8 LOT 2J LOT AREA .56 Acre SITE CLASS. PS DESIGN FLOW 360gpd L.T.A.R. 3

Septic Tank: 1000 Gallons; STB 1012 Date 3-14-07

Pump Tank: 1000 Gallons; PT 17 Date 3-7-07

Pump Make Goulds Model WE0312M Serial No.

Nitrification Field: No Fields 1 Square Feet 900' Linear Feet 300'

No Lines 3 @ 100' Trench Width 36" Max Trench Bottom Depth 36" Gravel Depth N/A

☒ New System ☐ Repair ☐ Expansion System Type: I II III IV V VI

System Description: Pump-PM-25% Reduction

Repair System Description Pump-LP-25-50% Reduction

Maintenance Agreement Required: ☐ Yes ☒ No Not Initially

☒ House/Mod. Home ☐ Mobile Home ☐ Business ☐ Other

No. Bedrooms 3 No. Persons No. Employees


Water Supply: ☐ Individual ☐ Public ☒ Community

☐ Gravity ☐ Pressure ☐ Slab ☐ Crawl Space ☐ Basement w/plumbing ☐ Basement wo/plumbing

Comments:/Conditions: Keep Septic System at least 10ft from PL, 15ft from Cut > 2ft & 10ft from house (if no foundation drain).

Comments:/Conditions: 9/12/07 Checked tanks, lines & pressure

Scale 1:60 INITIAL SITE SKETCH

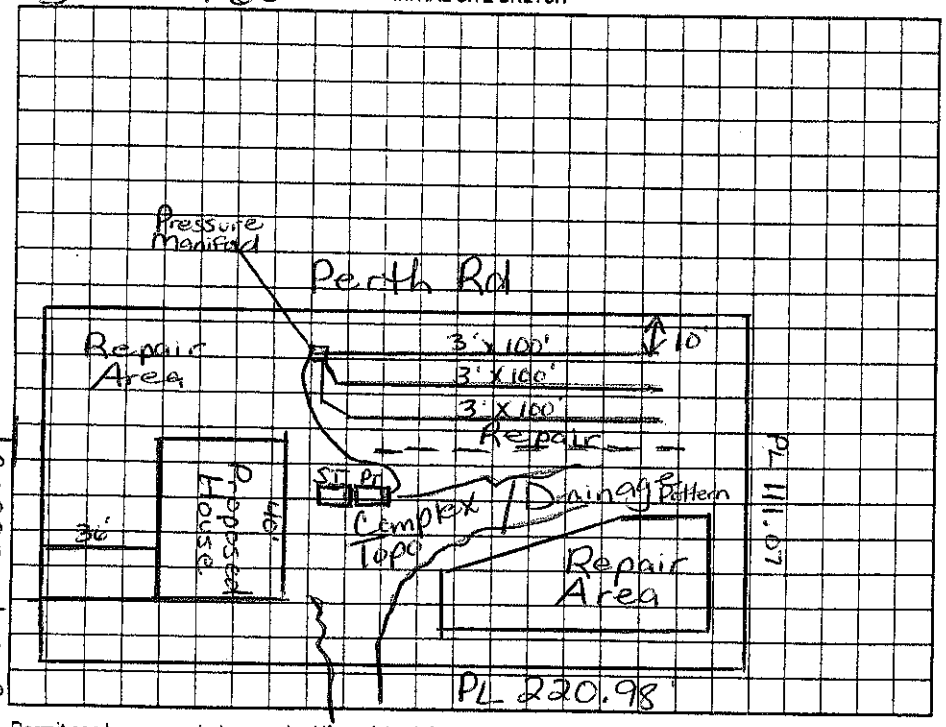


AS BUILT SKETCH

Installed Quick 4 as Drawn

Permit can be suspended or revoked if any false information is supplied toward securing the permit/any unauthorized changes are made to the site/any unauthorized changes are made in the installation of the system. Improvement Permit with plat valid without expiration ☐ Improvement Permit with site plan valid for sixty months ☐ Authorization to Construct is valid for a period equal to that of Improvement Permit – not to exceed sixty months.

Signed: date

Improvement Permit by: RS date 4/26/06

Authorization to Construct by: date 4/26/06

Installed by: A-1 Backhoe RS

Operation Permit by: date 12/12/07

Existing System Inspection by: date

HEALTH DEPT. COPY: WHITE OWNER COPY (FINAL): YELLOW OWNER COPY (INITIAL): PINK