IREDELL COUNTY HEALTH DEPARTMENT

STATESVILLE 704-878-5305 MOORESVILLE 704-664-5281

IMPROVEMENT PERMIT / AUTHORIZATION TO CONSTRUCT / OPERATION PERMIT / EXISTING SYSTEM INSPECTION

PERMIT# 066570 PIN# ~~4638-77-1716~~ 4638-78-7894 DATE Feb 5, '98

OWNER OR CONTRACTOR Stumpy Creek LLC / OGDEN CONST. PHONE: Business 633-6124 Home

ADDRESS 614 N. Main Salisbury N.C. 28144

LOCATION Perth Rd. N. TL Tanager Lane 1st lot on Right

SUBDIVISION Harborview BLOCK / SECTION VIII LOT 14 LOT AREA .56 SITE CLASS. PS DESIGN FLOW 360gpd L.T.A.R. .3

Septic Tank: 1000 Gallons; STB 1012 Date 10-7-00

Pump Tank: Gallons; PT Date

Pump Make: Model Serial No.

Nitrification Field: No Fields 1 Square Feet 900 Linear Feet 300

No Lines 4@75' Trench Width 36" Max Trench Bottom Depth 30" Gravel Depth N-1

☑ New System ☐ Repair System Type: I, II, ⓘ IV, V, VI

System Description: Gravity Modified 25% Reduction

Repair System Description: Gravel pumped Modified

Maintenance Agreement Required: ☐ Yes ☐ No

☑ House/Mod. Home ☐ Mobile Home ☐ Business ☐ Other

No. Bedrooms 3 No. Bathrooms 2 No. Employees

Water Supply: ☐ Individual ☐ Public ☑ Community

☐ Slab ☑ Crawl Space ☐ Basement w/plumbing ☐ Basement wo/plumbing

Comments:/Conditions: * ONE INspection/observation port per Lateral/

Remove old Farm TERRACE/Berm

Comments:/Conditions: Riser installed


Checked upper 3 lines (1,2&3) "Plastic Chambers"

Checked last line D-box & filter 4/23/2001

Installed as Drawn, used "Plastic Chambers"

1"=60'

INITIAL SITE SKETCH

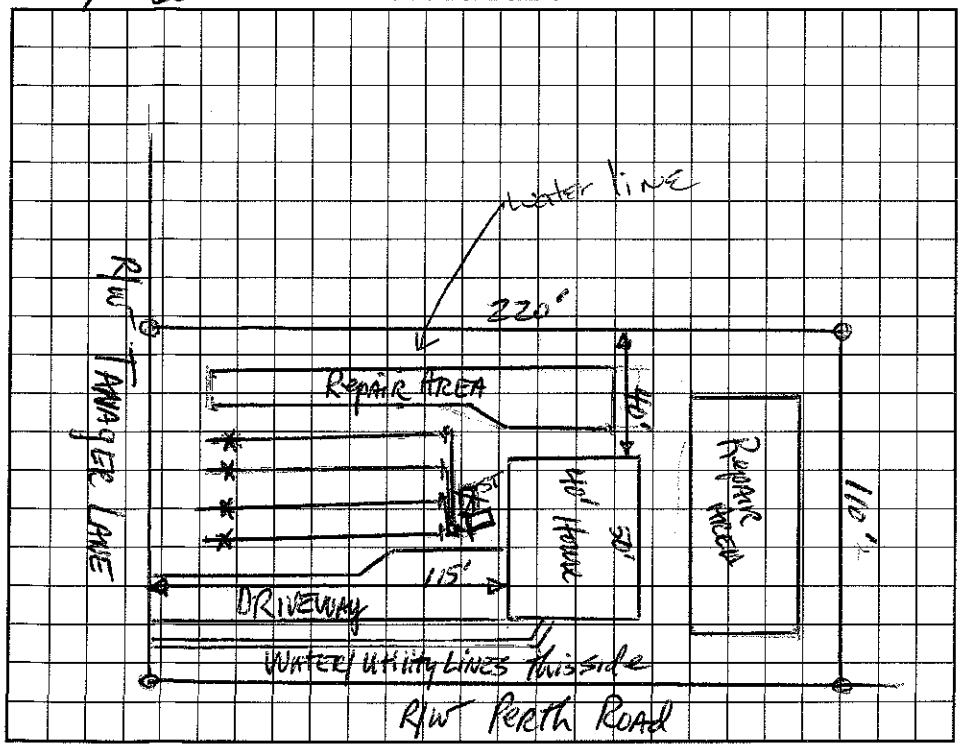

AS BUILT SKETCH

I understand that this permit can be suspended or revoked if any false information is supplied toward securing the permit/any unauthorized changes are made to the site/any unauthorized changes are made in the installation of the system. Improvement Permit with plat valid without expiration. Improvement Permit with site plan valid for sixty months. Authorization to Construct is valid for a period equal to that of Improvement Permit – not to exceed sixty months.

Signed: date

Improvement Permit by: Dave Thurman, RS date 2-5-98

Authorization to Construct by: C. [illegible] RS date 1/18/01

Installed by: Richard Abernathy date 4/30/2001

Operation Permit by: Maria A. [illegible] date

Existing System Inspection by: date

HEALTH DEPT. COPY: WHITE INSPECTION COPY (FINAL): GREEN OWNER COPY (FINAL): YELLOW INSPECTION COPY (INITIAL): PINK OWNER COPY (INITIAL): GOLD